


SECTION 13  
NW NW  
\_\_\_\_\_  
\_\_\_\_\_  
\_\_\_\_\_

# 4842- High Horse Spring

TOWNSHIP 23 S, RANGE 34 E, W. M.

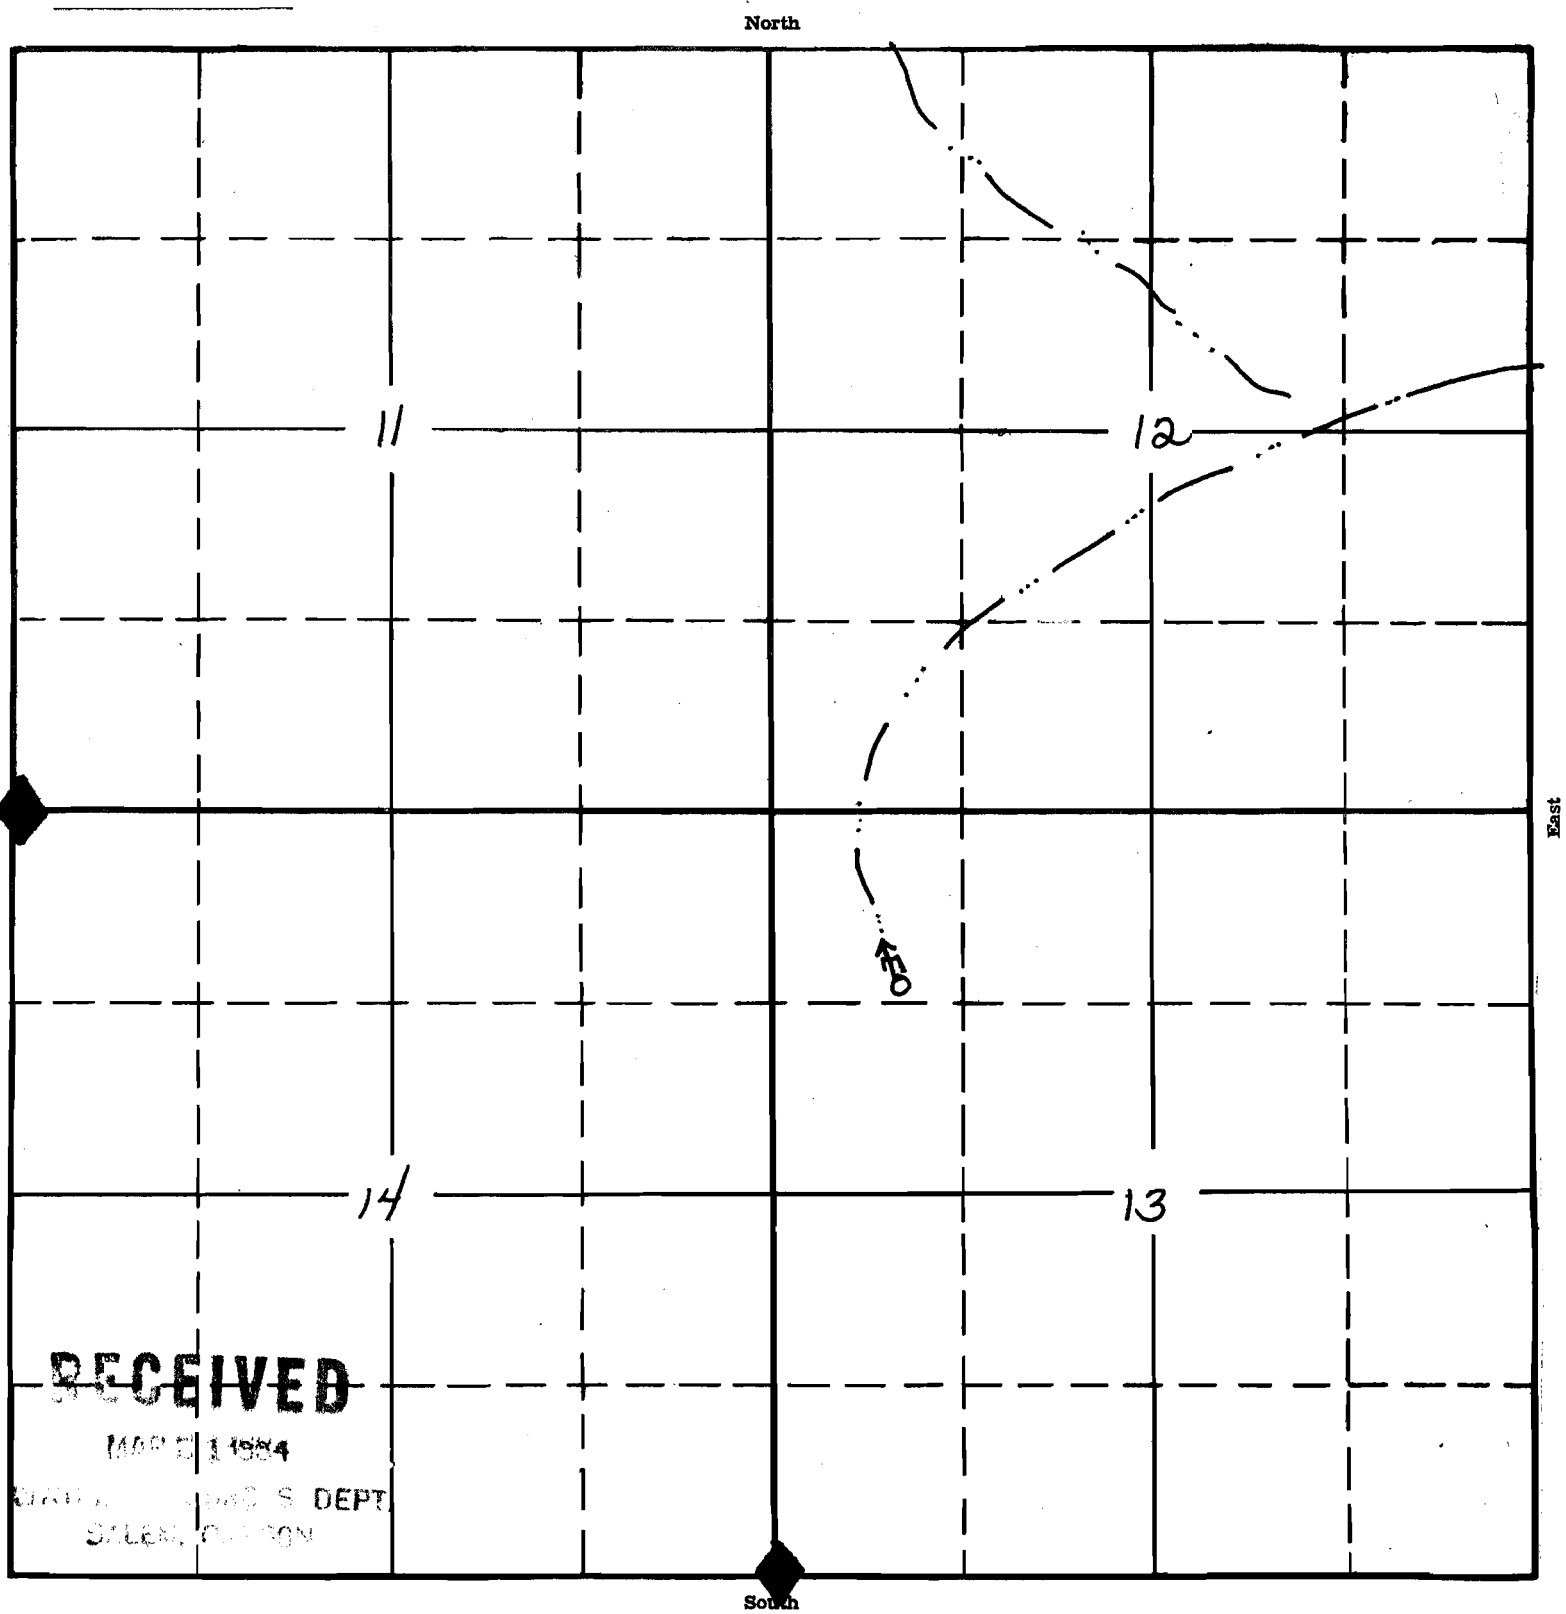

**RECEIVED**

MAR 21 1984

WATER RESOURCES DEPT.  
SALEM, OREGON

**RECEIVED**

SEP 19 1983

WATER RESOURCES DEPT.  
SALEM, OREGON

APPLICATION No. 66145

PERMIT No. 48379