


SECTION 9
NW SW

#4450 - Grange Spring

TOWNSHIP 20 S, RANGE 34 E, W. M.

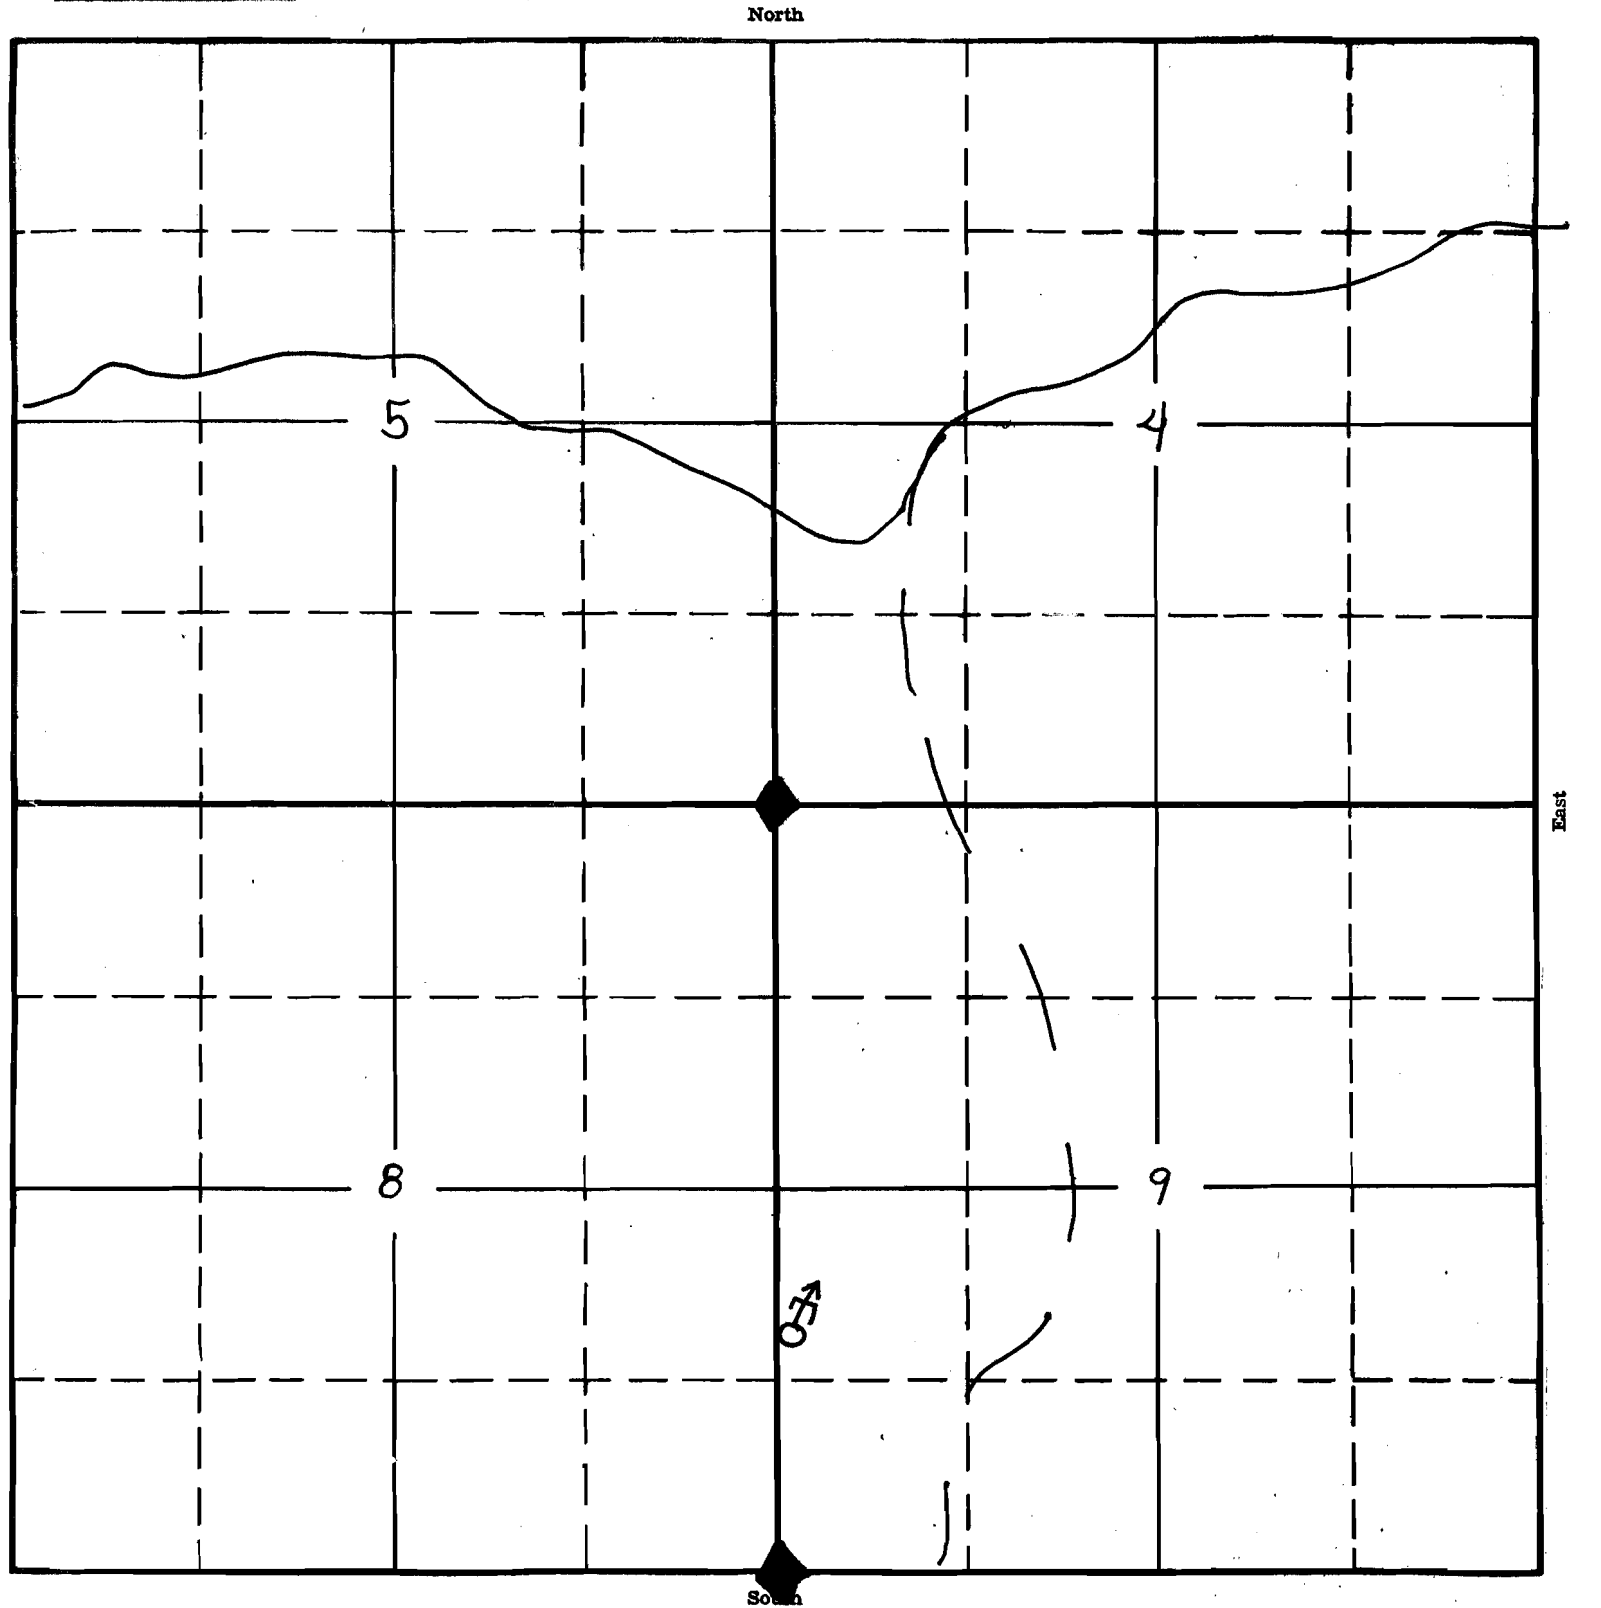

RECEIVED

SEP 19 1983
WATER RESOURCES DEPT.
SALEM, OREGON

APPLICATION No. 66147
PERMIT No. 48381