


SECTION 32

NE NW

#4178 - Sorrel Spring

TOWNSHIP 22S, RANGE 36E, W. M.

North

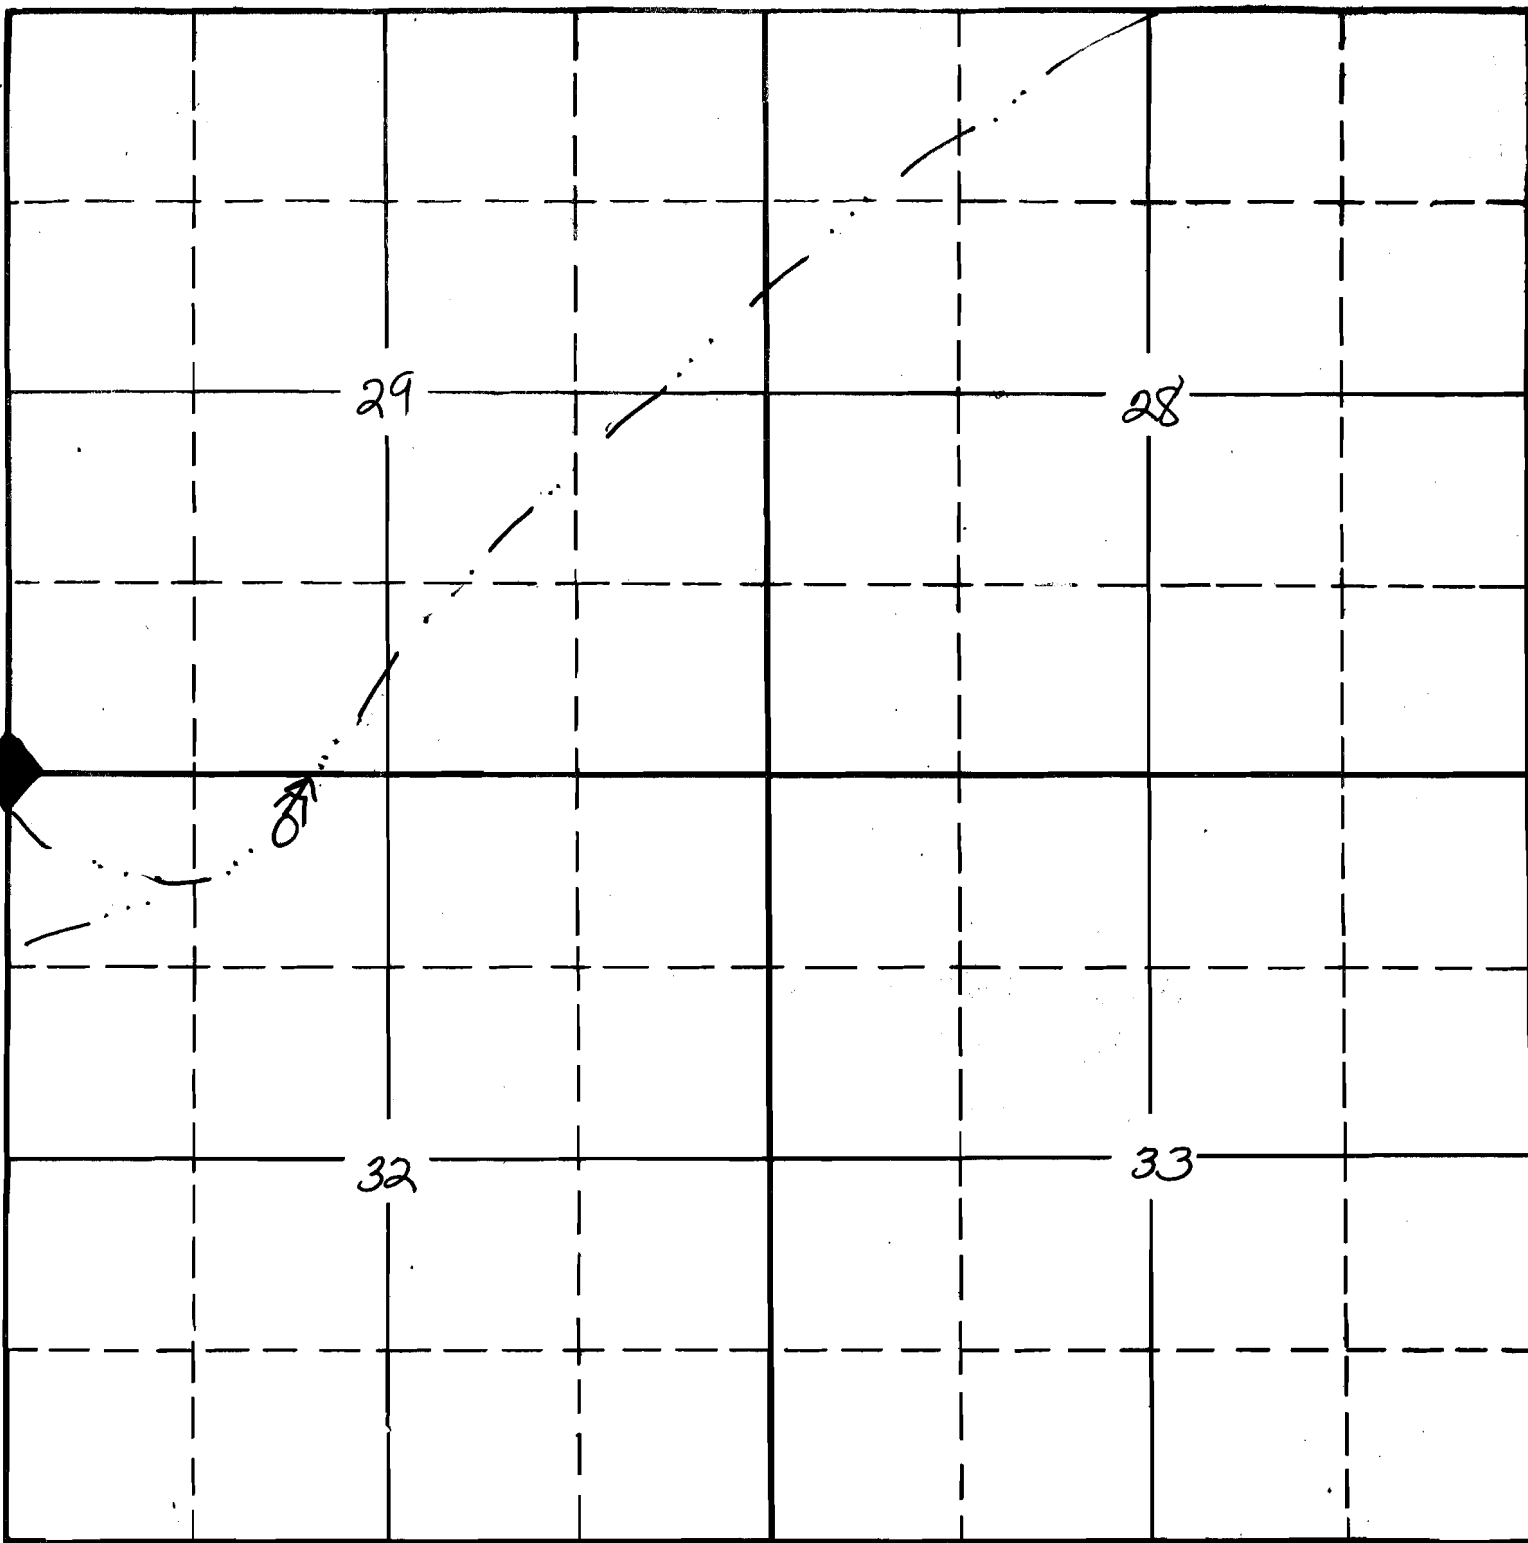

East

South

RECEIVED

SEP 19 1983

WATER RESOURCES DEPT.
SALEM, OREGON

APPLICATION No. 66/50

PERMIT No.

48384