


SECTION ~~SW~~ 14

#1082 - Crystal Spring

SW SW

TOWNSHIP 21 S, RANGE 34 E, W. M.

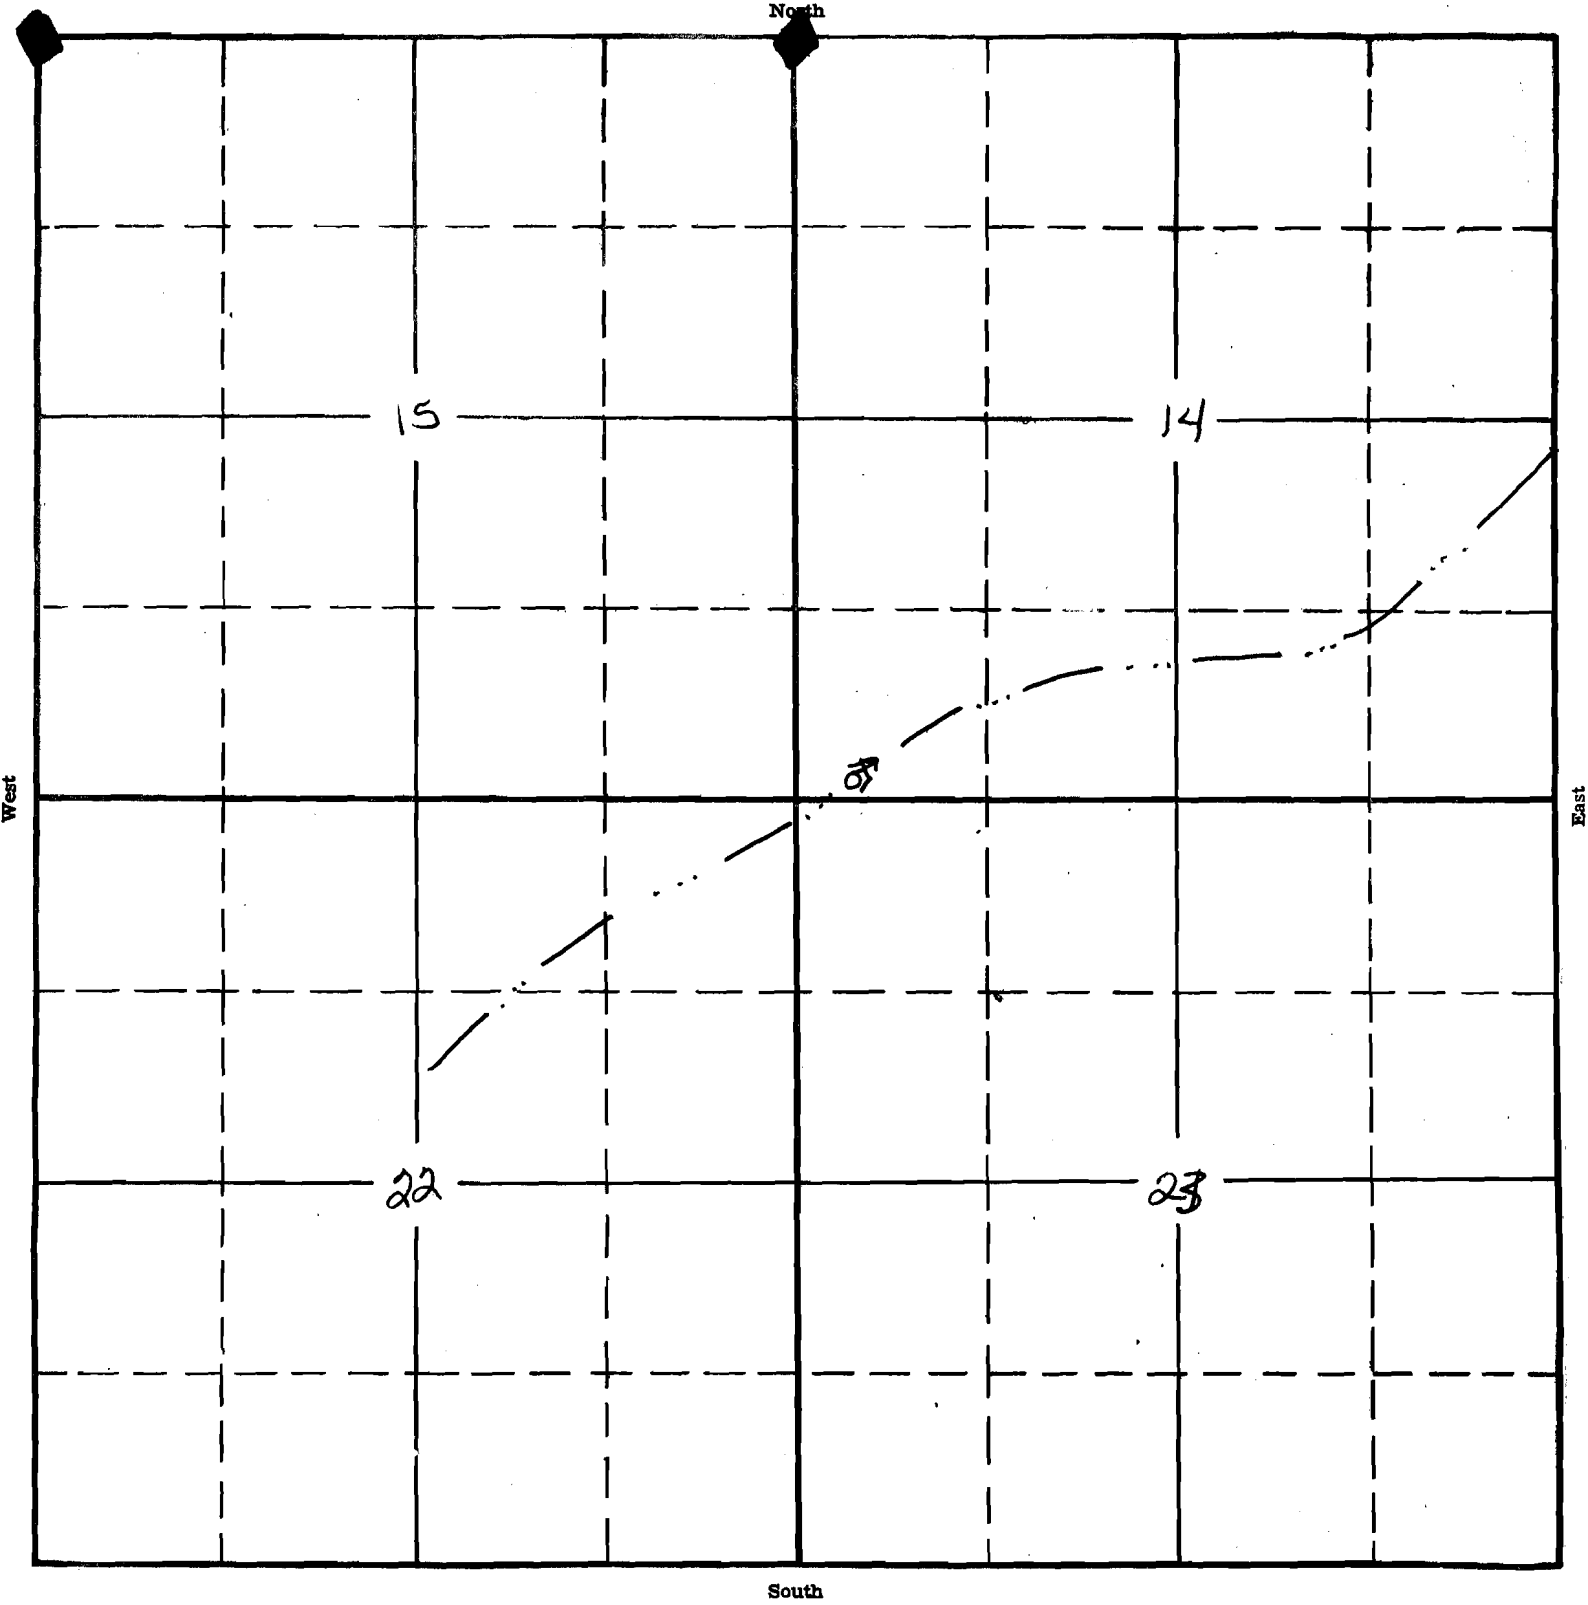

RECEIVED

SEP 19 1933
WATER RESOURCES DEPT.
SALEM, OREGON

APPLICATION No. 66154
PERMIT No. 48387