


SECTION 27
NESE

#1081- Highway Spring #1

TOWNSHIP 21 S., RANGE 134 E, W. M.

North

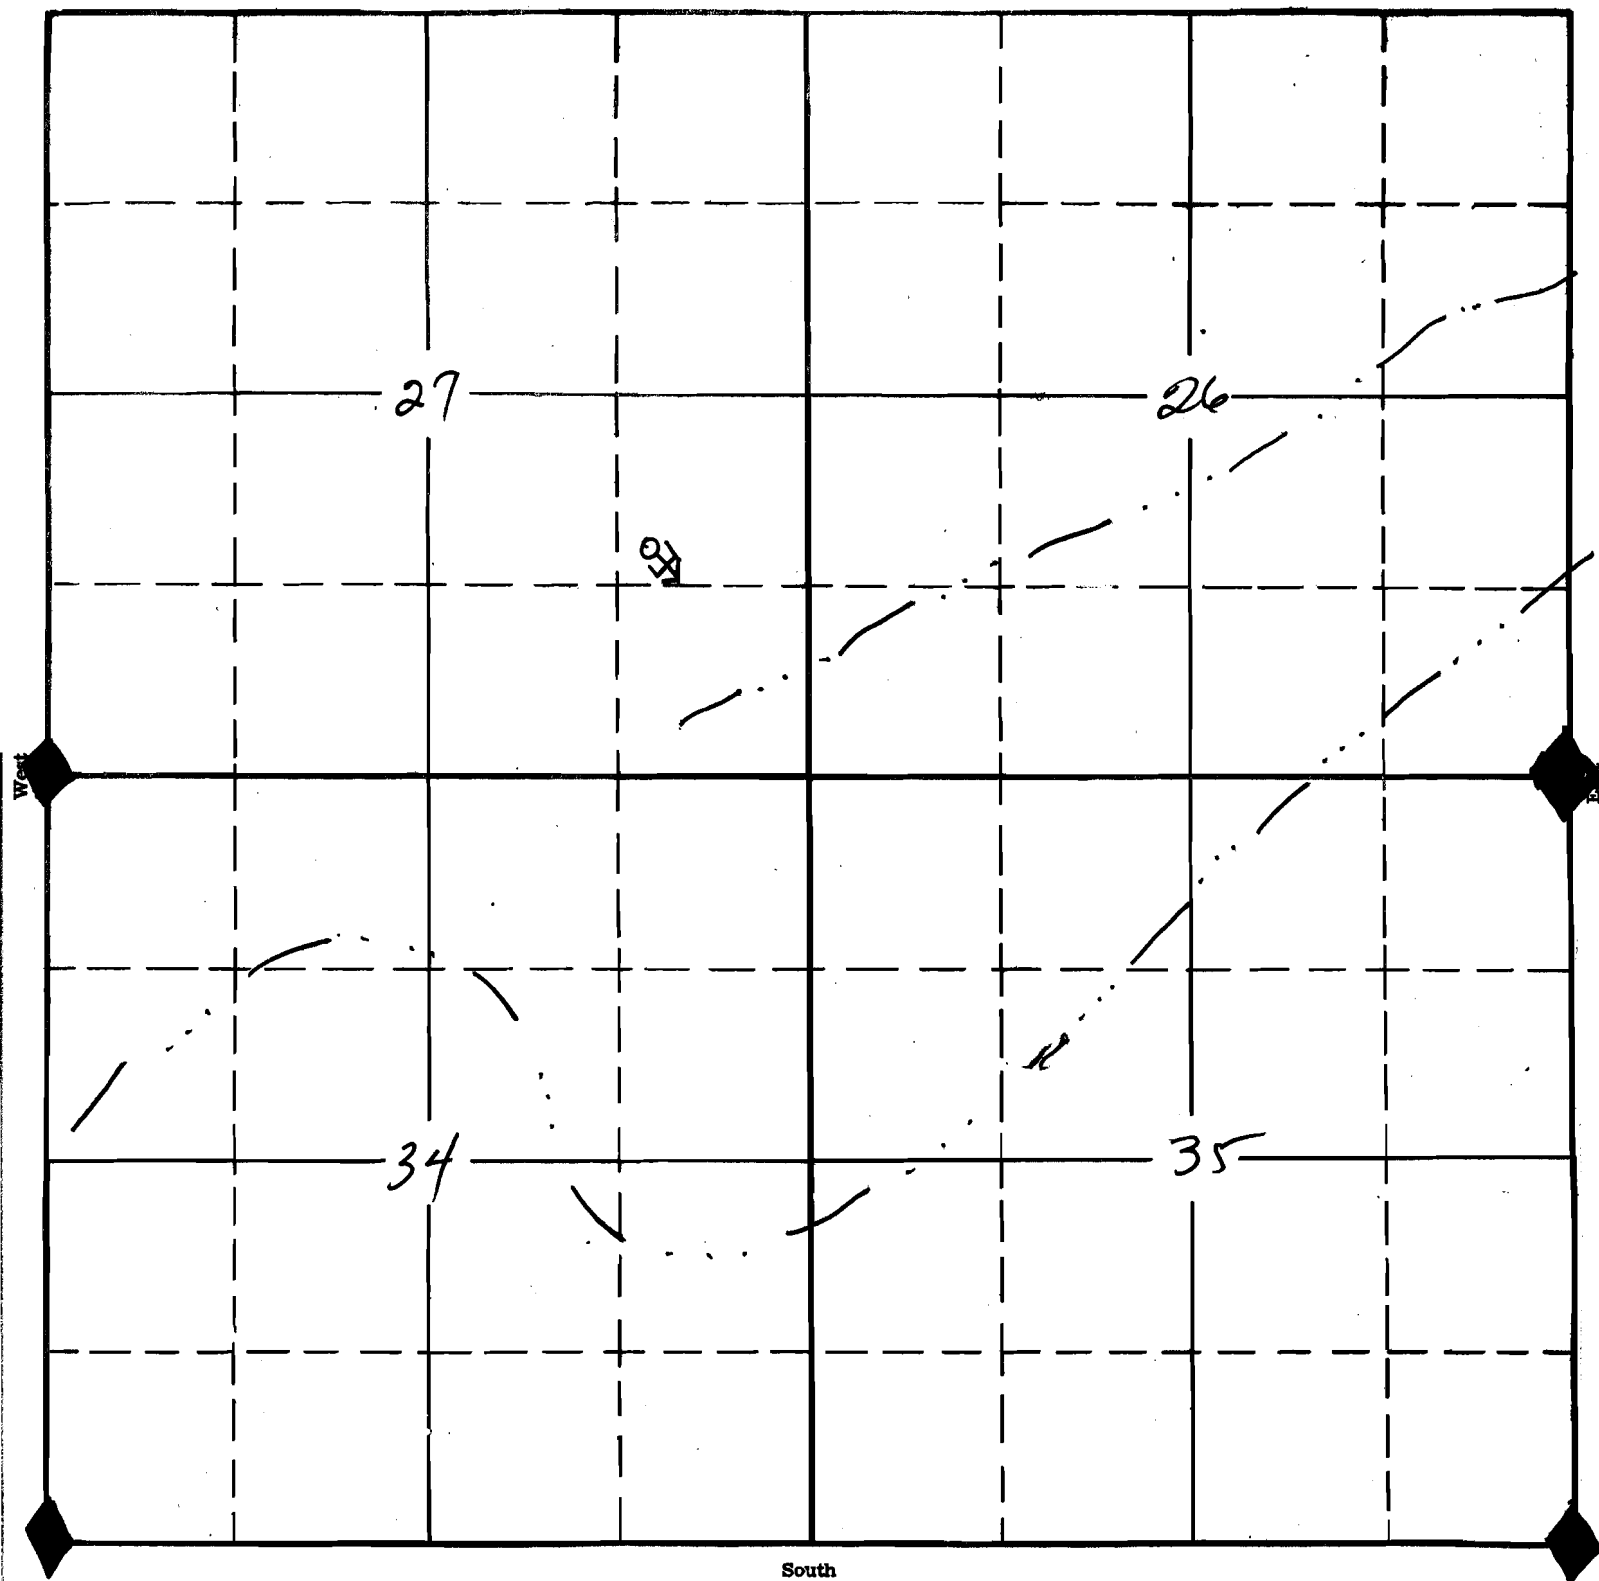

South

RECORDED

SEP 19 1933

WATER RESOURCES DEPT.
SALEM, OREGON

APPLICATION No. 66155

PERMIT No. 48388