

SECTION 31

NE NE


#1074- Basco (Fork) Spring

TOWNSHIP 18 S, RANGE 35 E, W. M.

North

West

East

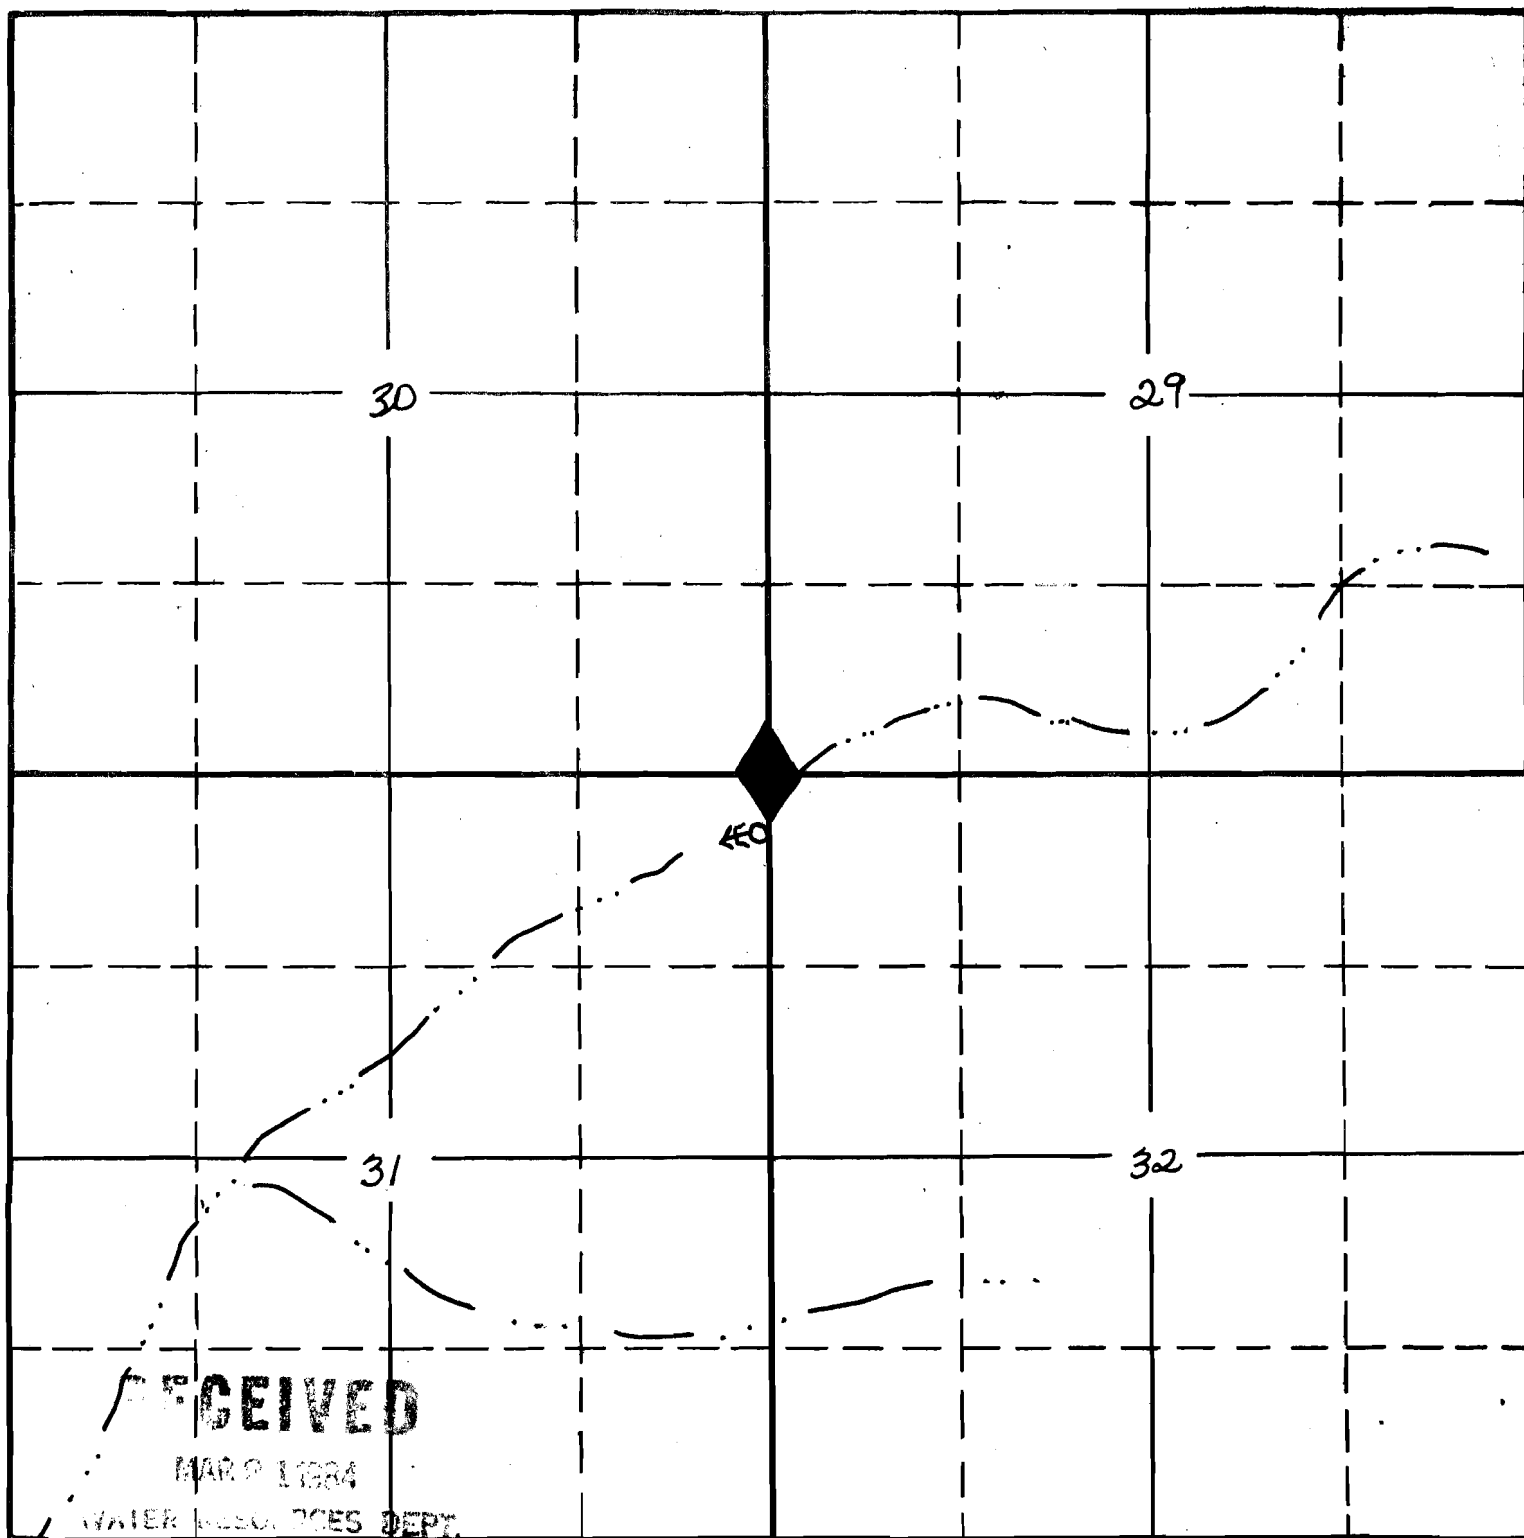

SALEM, OREGON

South

RECEIVED

SEP 19 1983

WATER RESOURCES DEPT.
SALEM, OREGON

APPLICATION No. 66156
PERMIT No. 48389