


SECTION 5

5308- Quaking Spring

SW NW

TOWNSHIP 22S, RANGE 32E, W. M.

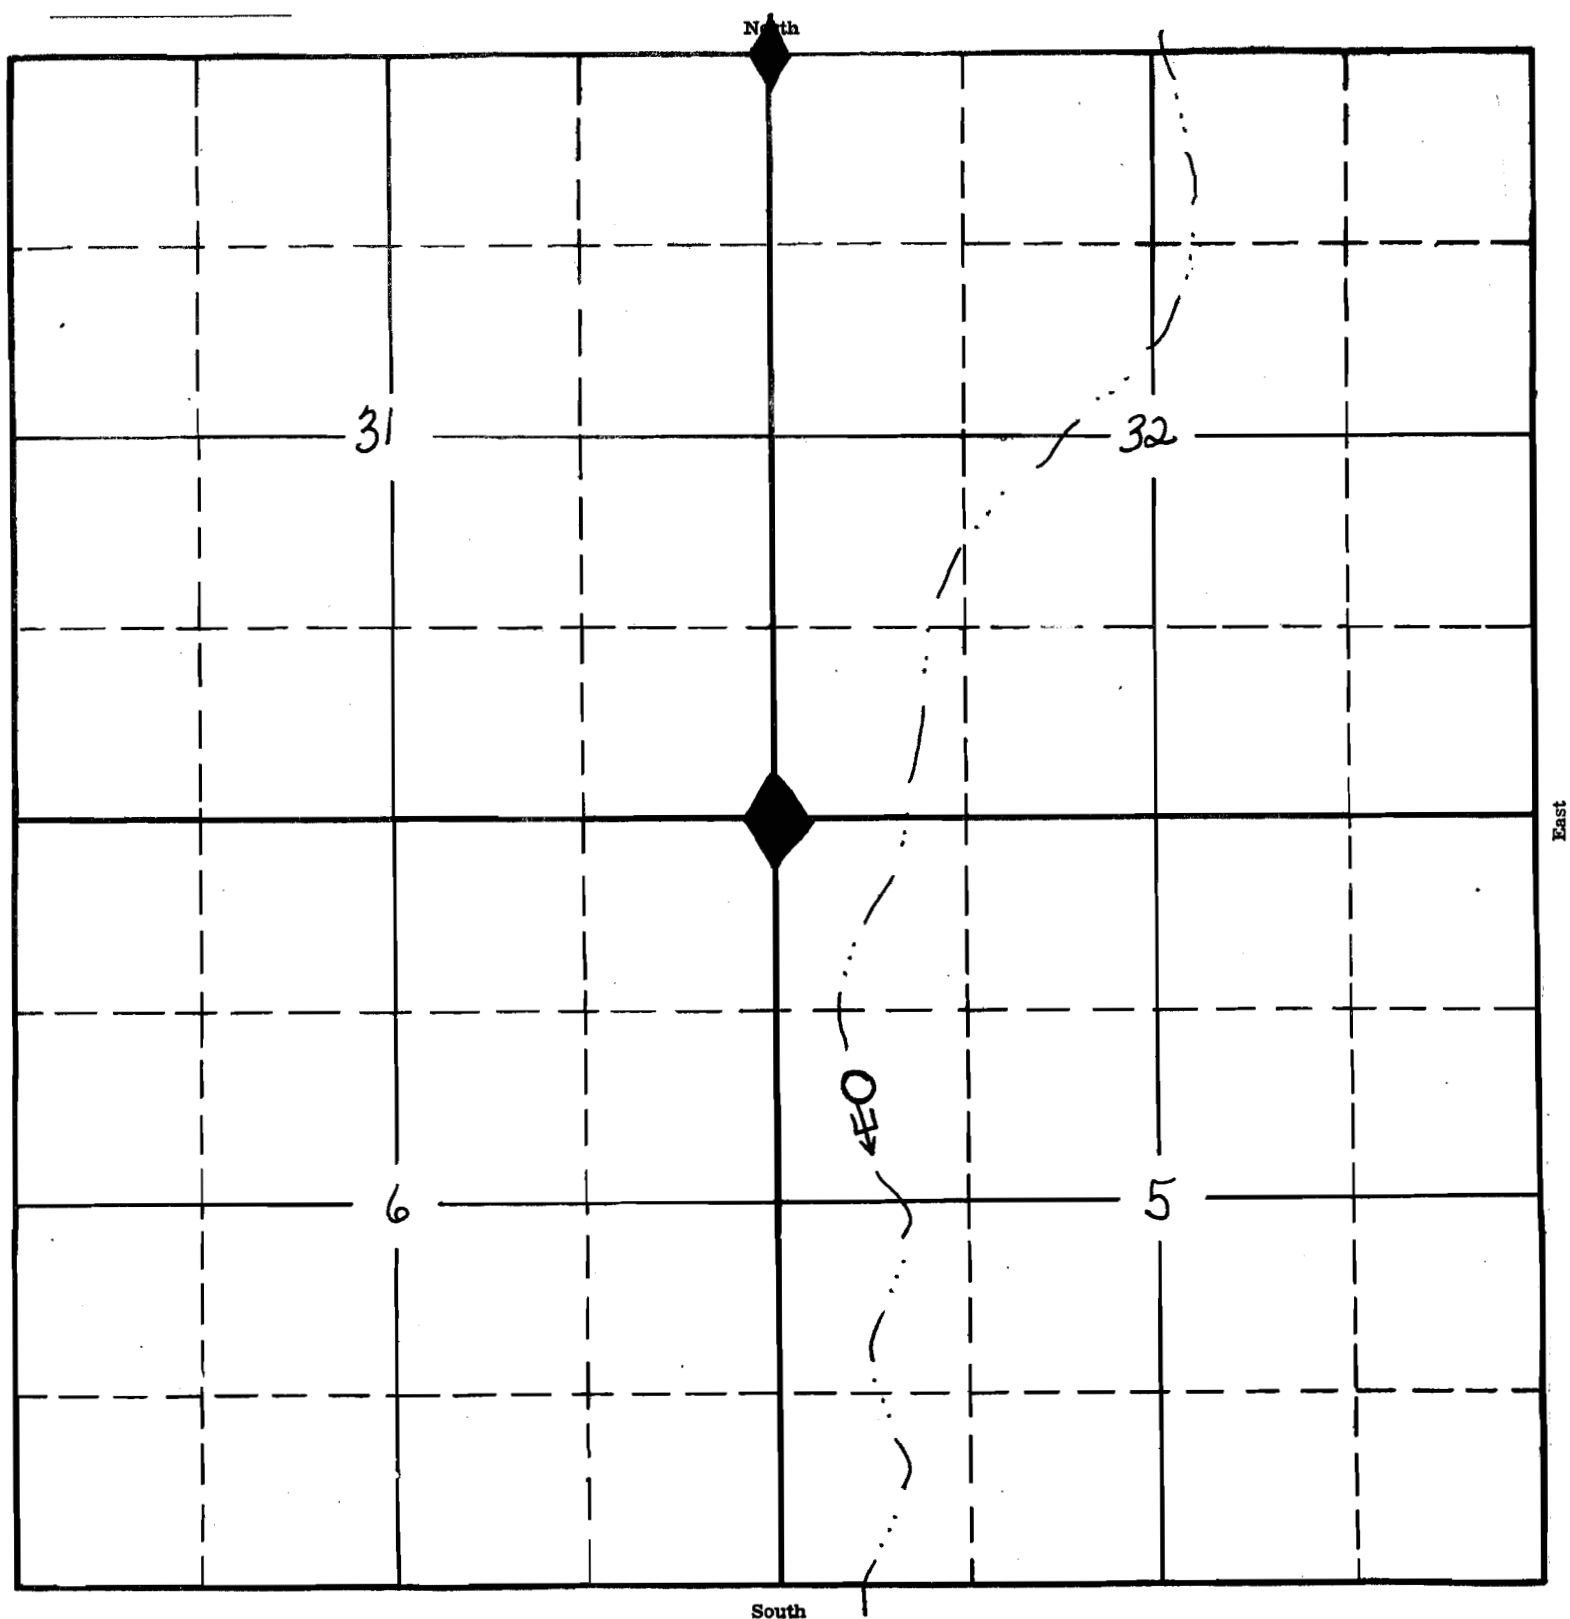

RECEIVED

SEP 19 1993
WATER RESOURCES DEPT.
SALEM, OREGON

APPLICATION No. 66159
PERMIT No. **48392**