SECTION

3 - NE NW

TOWNSHIP 24 S., RANGE 34 E., W. M.

#5366 - Rector Spring

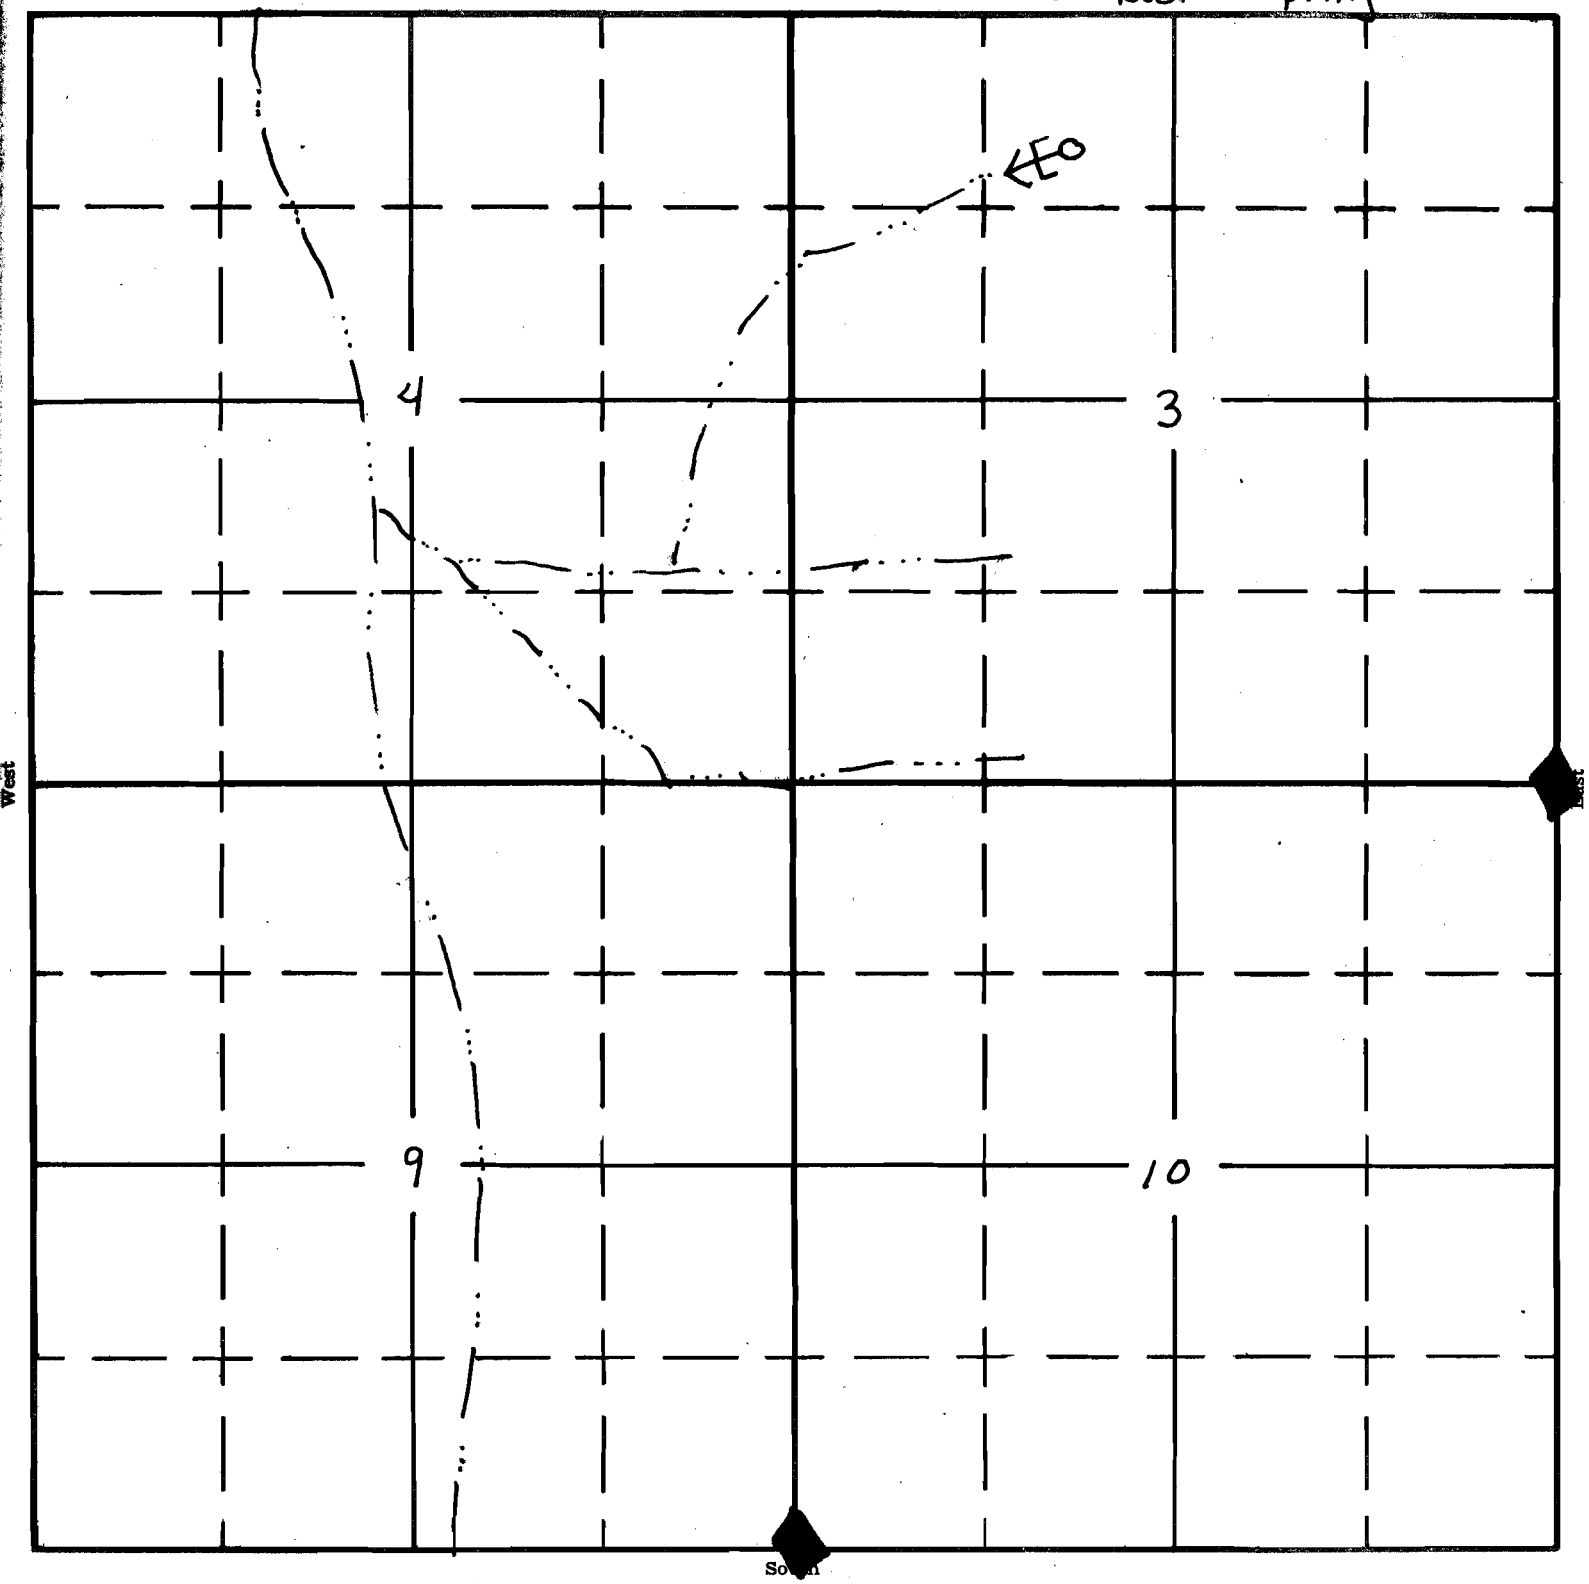

RECEIVED

SEP 19 1983

WATER RESOURCES DEPT.
SALEM, OREGON

Application No. 66167

Permit No. 48398