


RECEIVED
WATER RESOURCES DEPT.
Salem, Oregon

T. 21 S., R. 35 E., W.M.

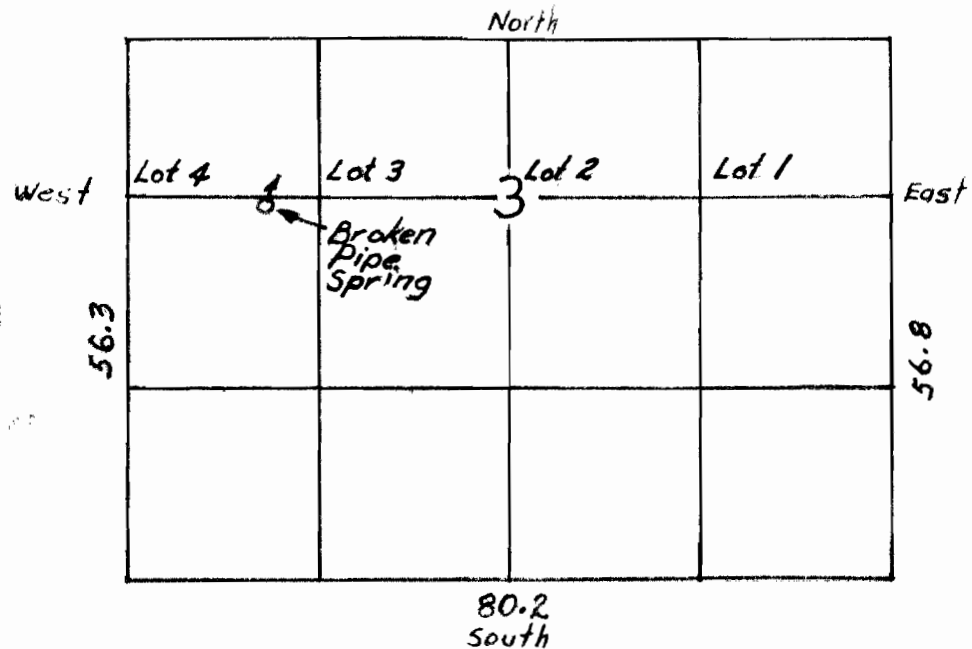

RECEIVED
WATER RESOURCES DEPT.
SALEM, OREGON

Scale 4" = 1 mile

Application No. 66115
Permit No. 49180