35 SE SW

TOWNSHIP 11S, RANGE 26E, W. M.

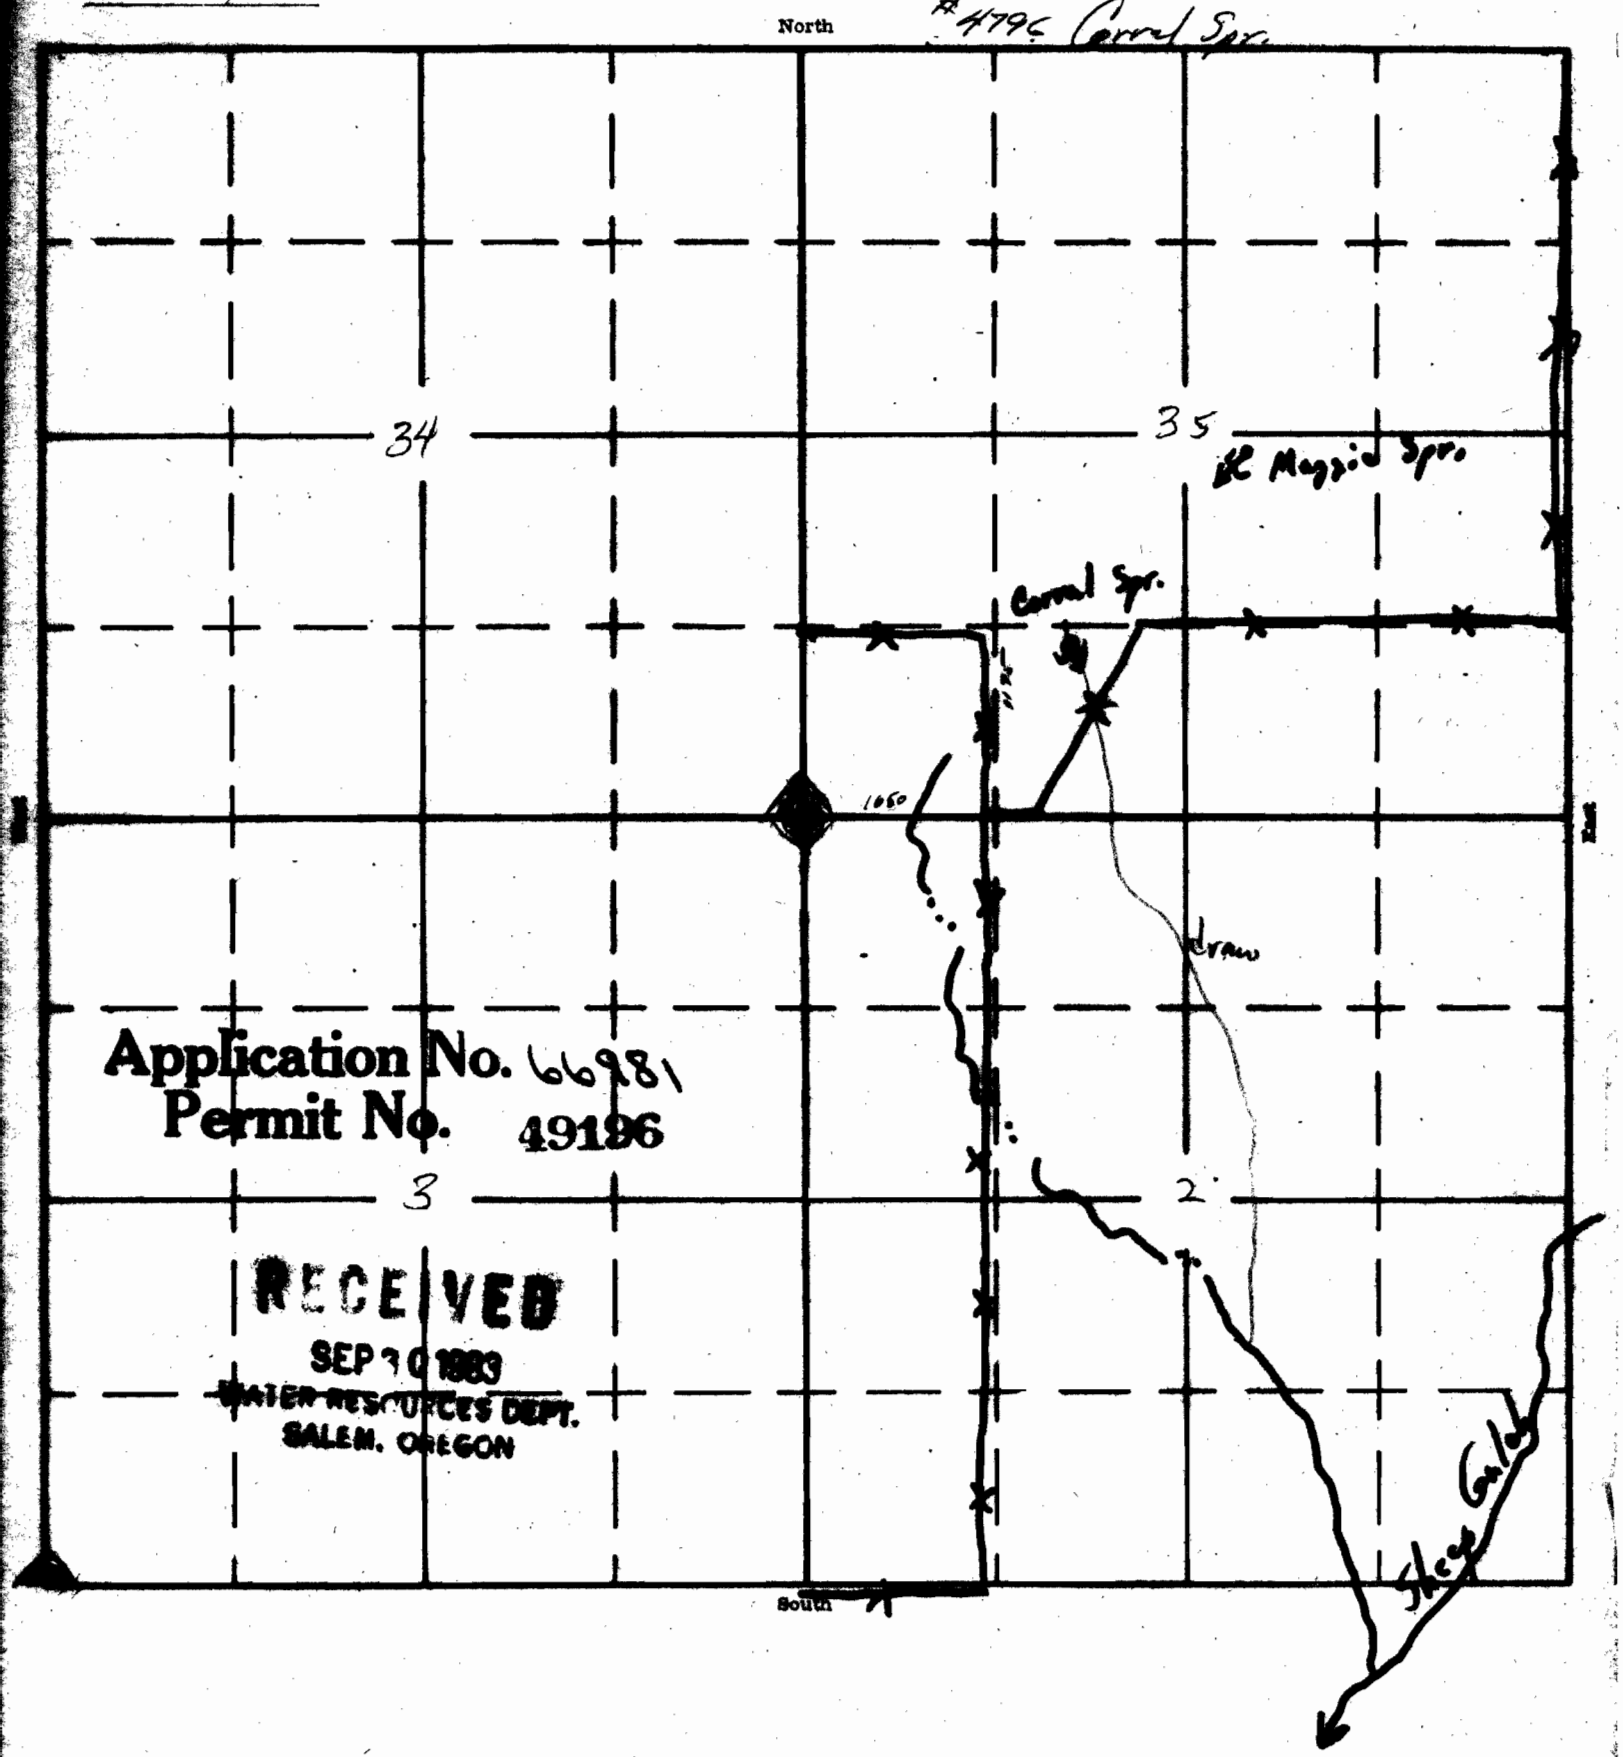

Application No. 66981
Permit No. 49196

RECEIVED
SEP 30 1983
WATER RESOURCES DEPT.
SALEM, OREGON