


SECTION

4 SE SW

TOWNSHIP 12S, RANGE 26E, W. M.

North #4800 Cactus Spr.

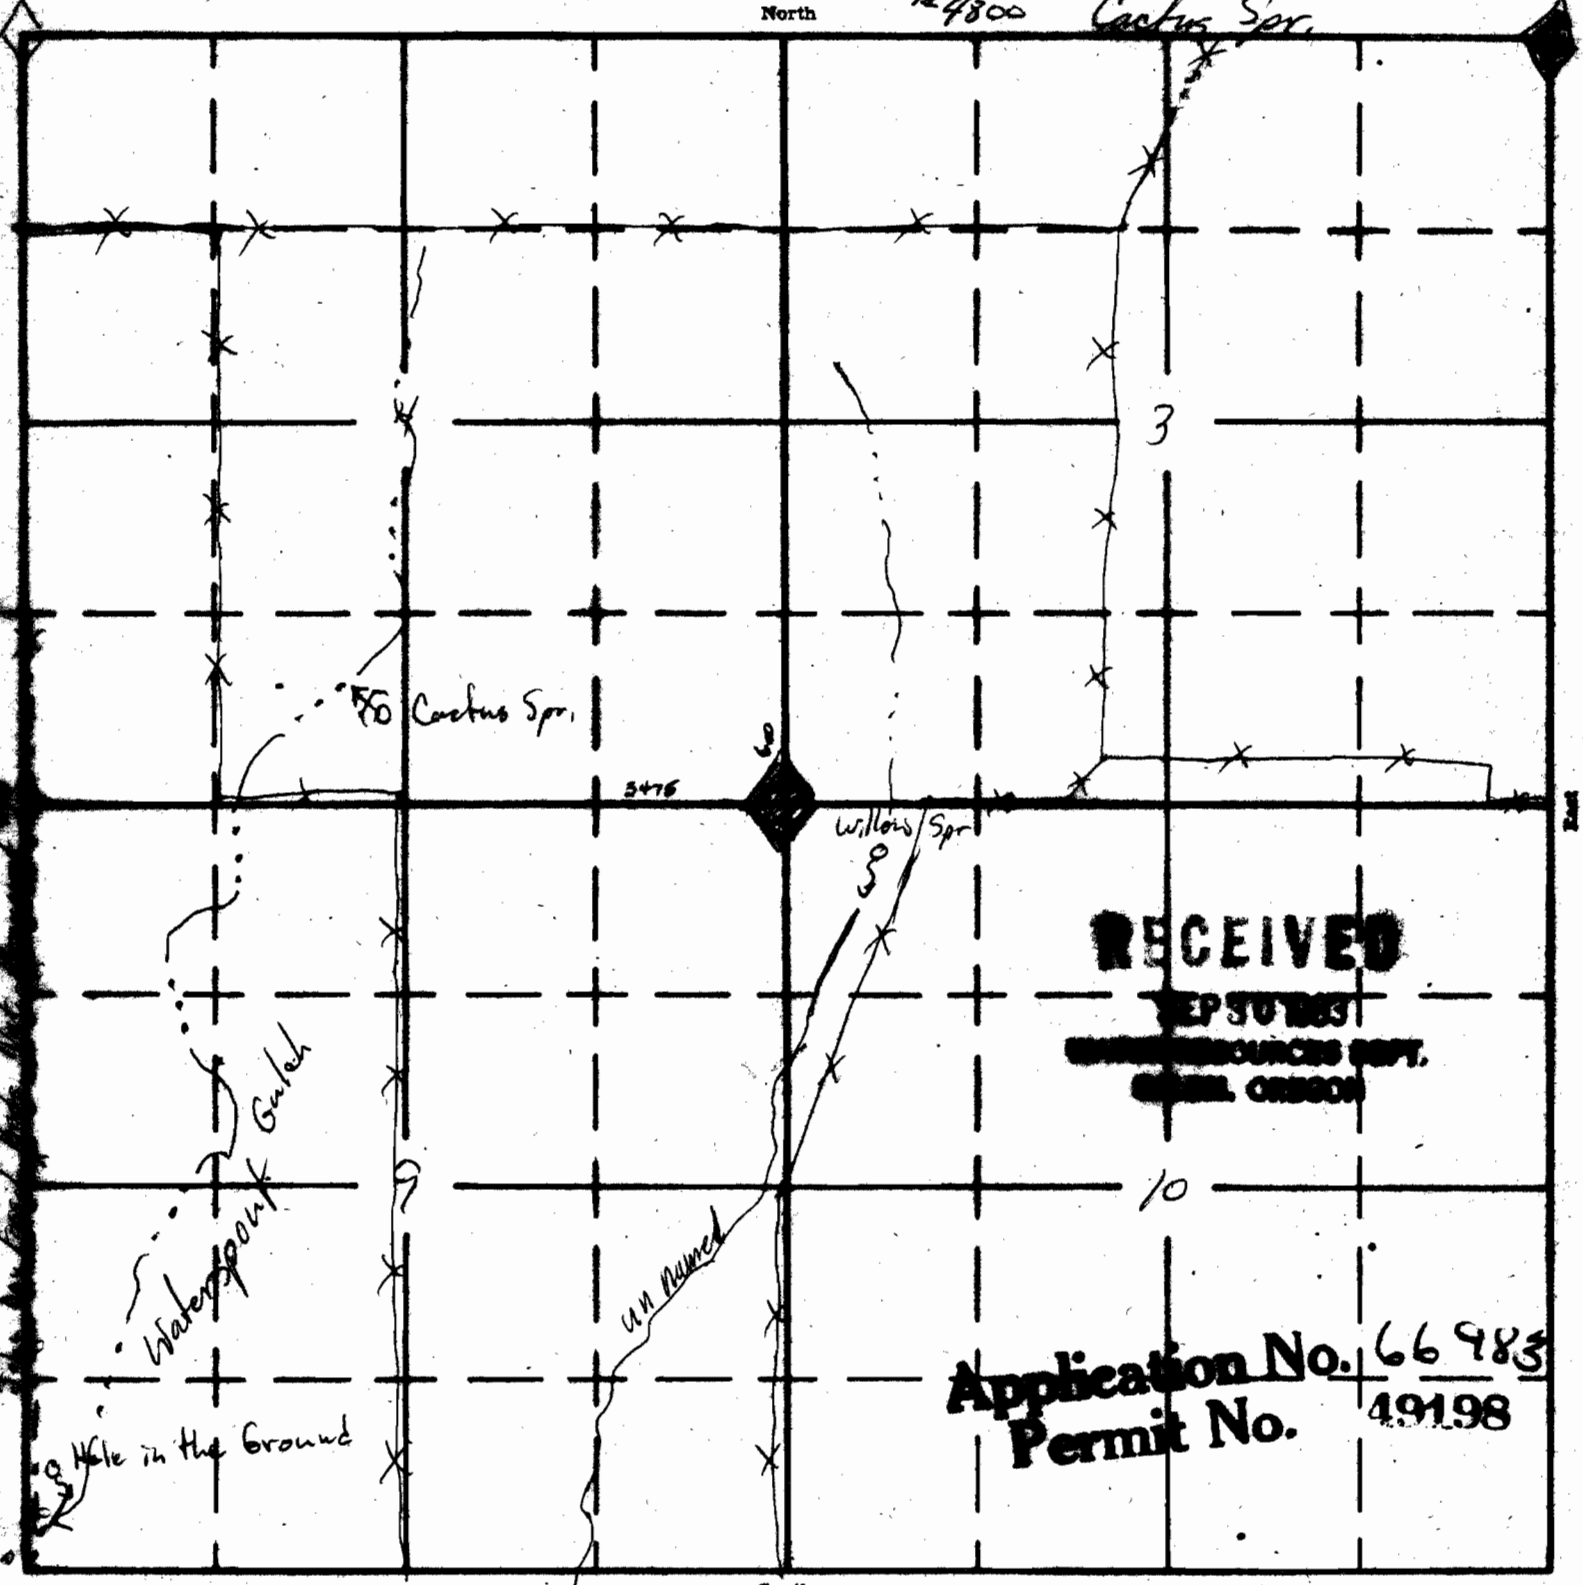

RECEIVED


10

Application No. 66983
Permit No. 49198

South

to John Day River