


SECTION 33 SE SW

TOWNSHIP 14S, RANGE 21E, W. M.

North * 4449 Bull (Pasture) Spr.

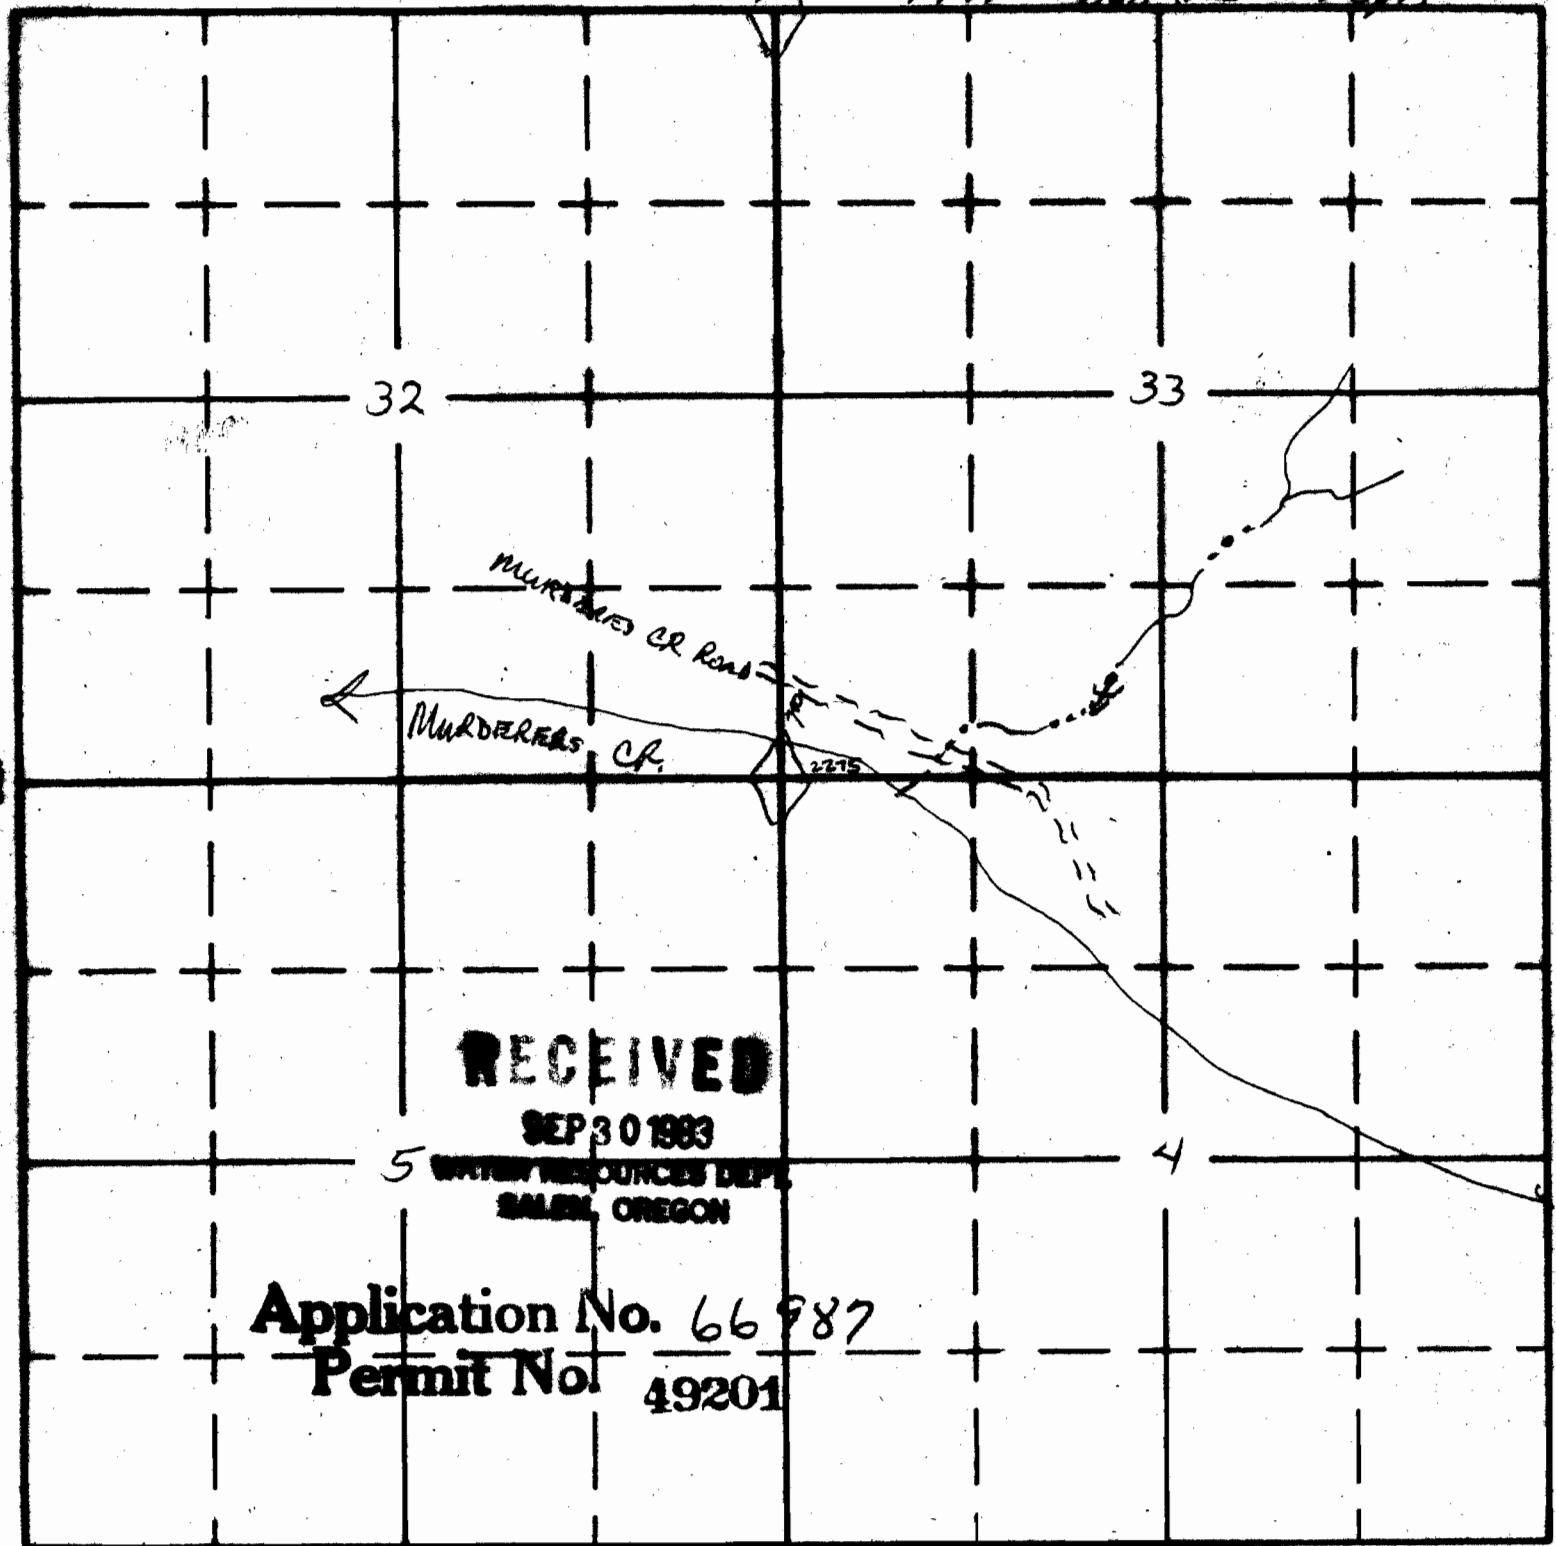

South