


SECTION

20

SW NE

TOWNSHIP 13S, RANGE 27E, W. M.

#4449 Spr. No. 3 (Grey Gulch)

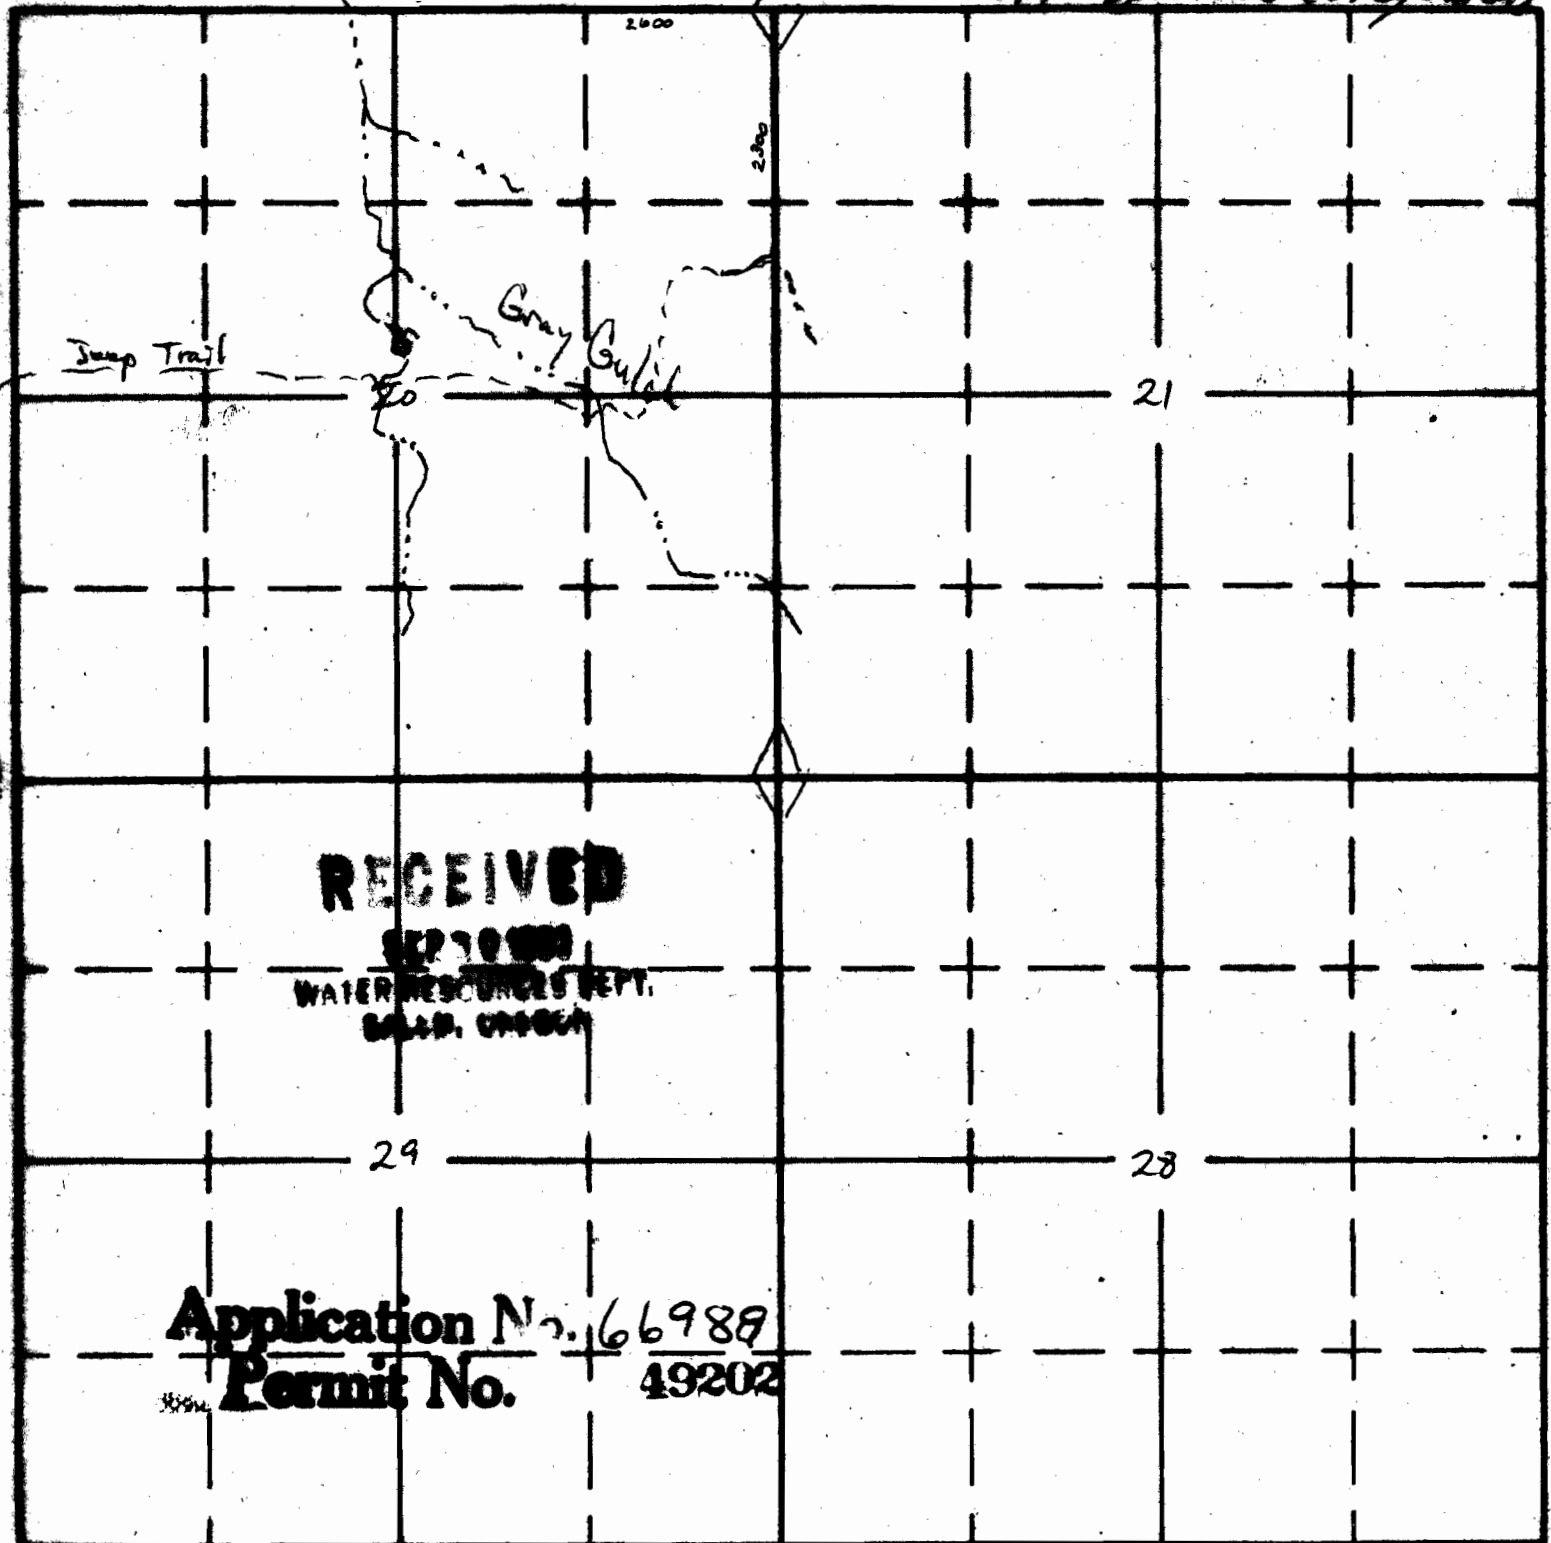

South