

SECTION

20 NESE

TOWNSHIP 14S, RANGE 27E, W. M.

Application No. 66990

North

#4249 Forks (Mtn) Spring


Permit No.

49203

RECEIVED

SEP 30 1983

WATER RESOURCES DEPT.
BUREAU OF RECLAMATION

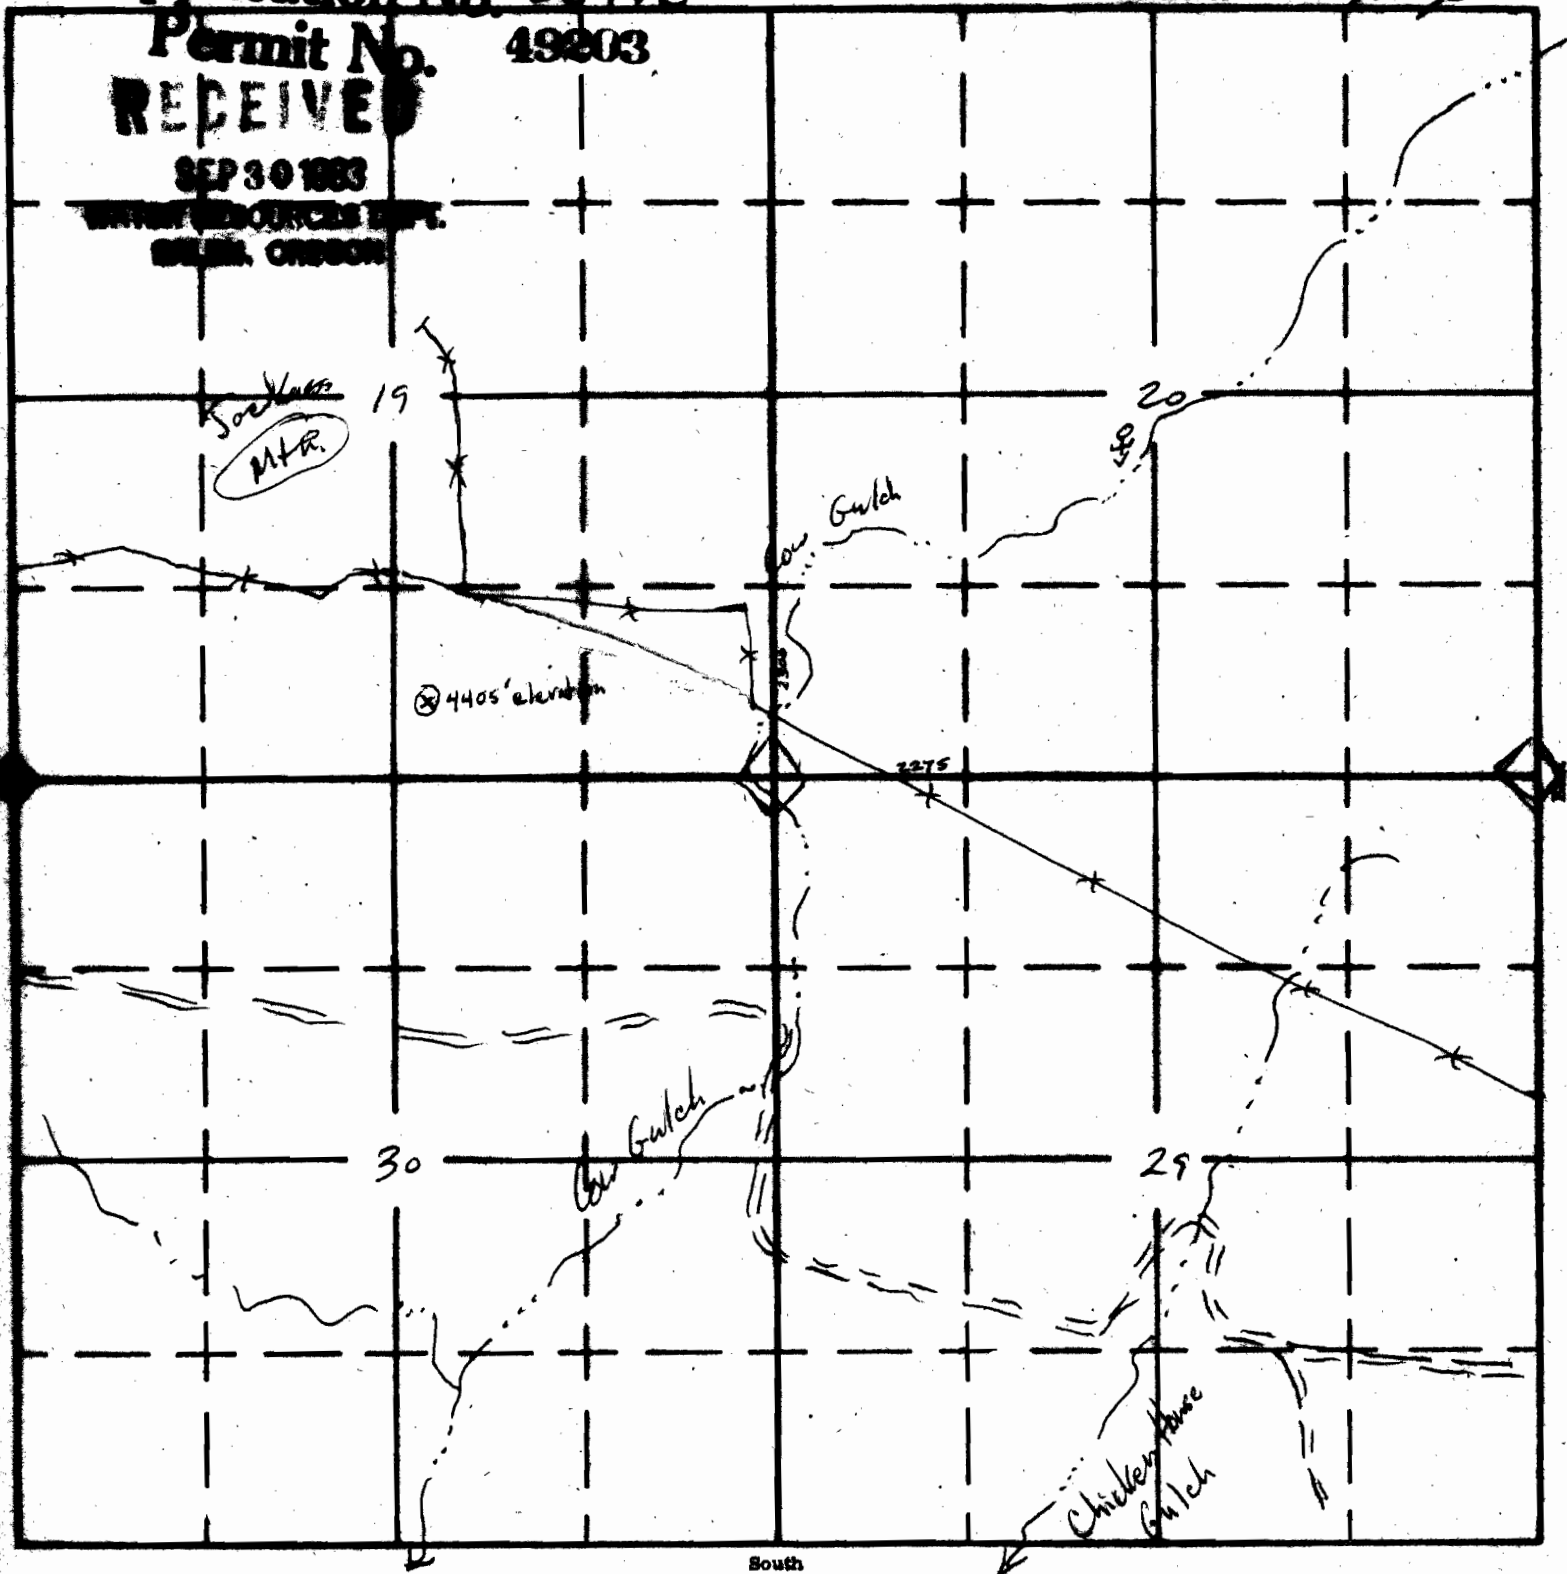

South