





NE 1/4 SW 1/4

TOWNSHIP 20S, RANGE 3SE, W. M.


North

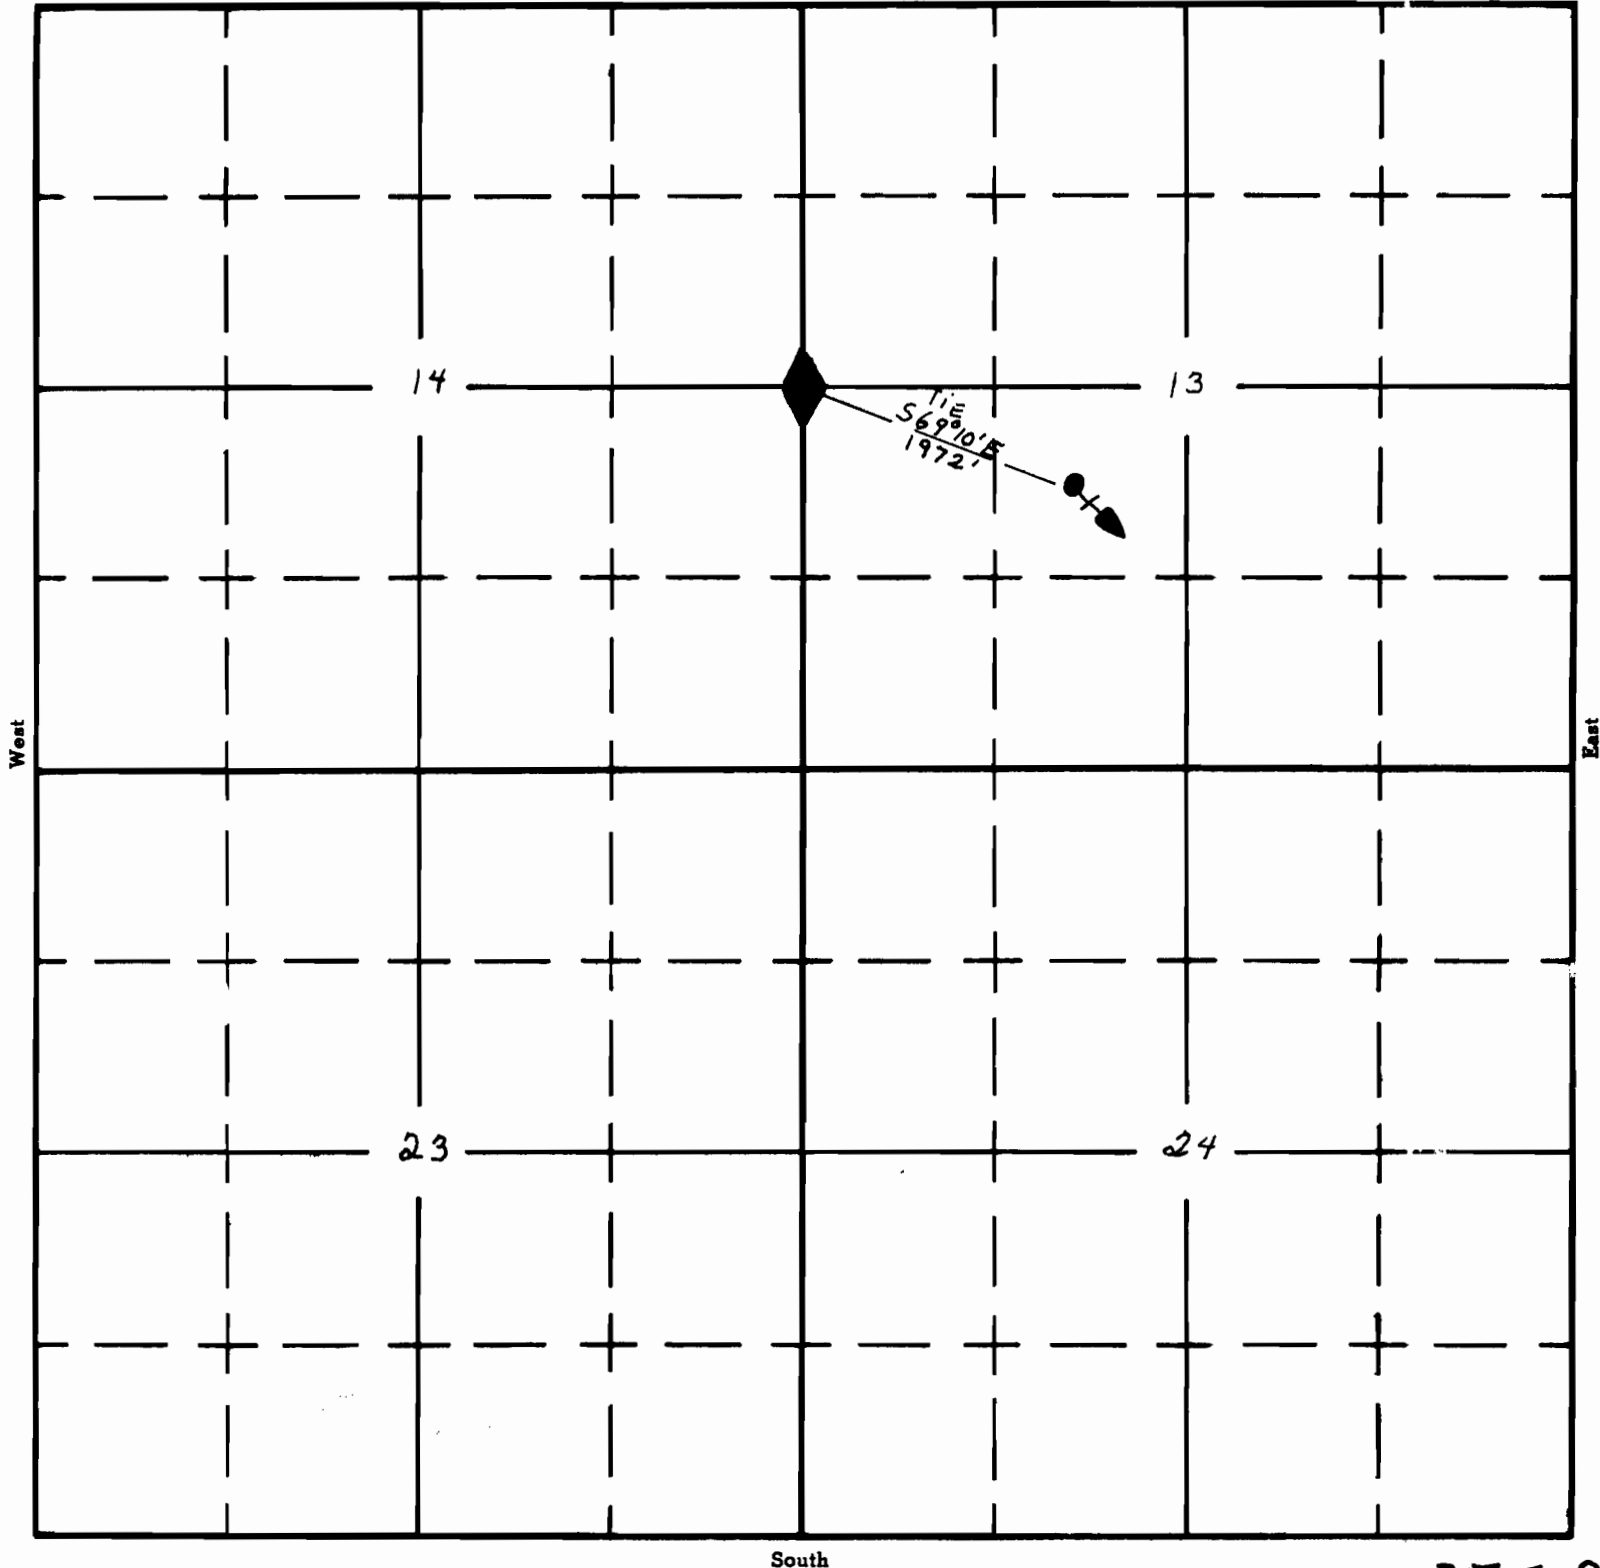

South

APPLICATION No. **35708**
PERMIT No. **1969**