


RECEIVED

MAY 27 1999

WATER RESOURCES DEPT.
SALEM, OREGON

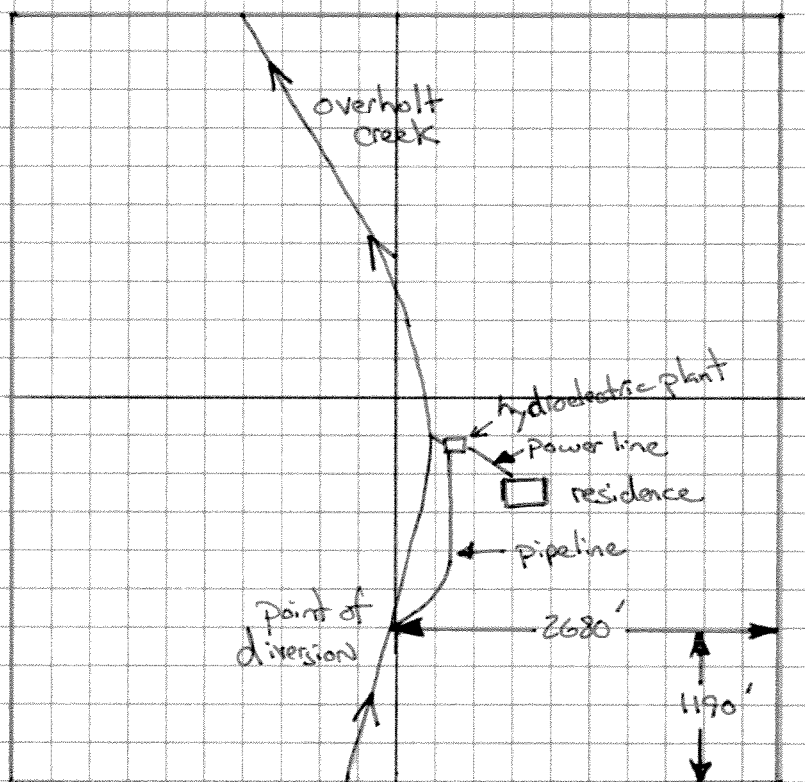

4" = 1 mile

T14S R33E Section 14

HE 349