

UNITED STATES
DEPARTMENT OF THE INTERIOR
BUREAU OF LAND MANAGEMENT


SECTION

19

Oregon State Water Filings

TOWNSHIP 12 S, RANGE 4 E, W. M.

North

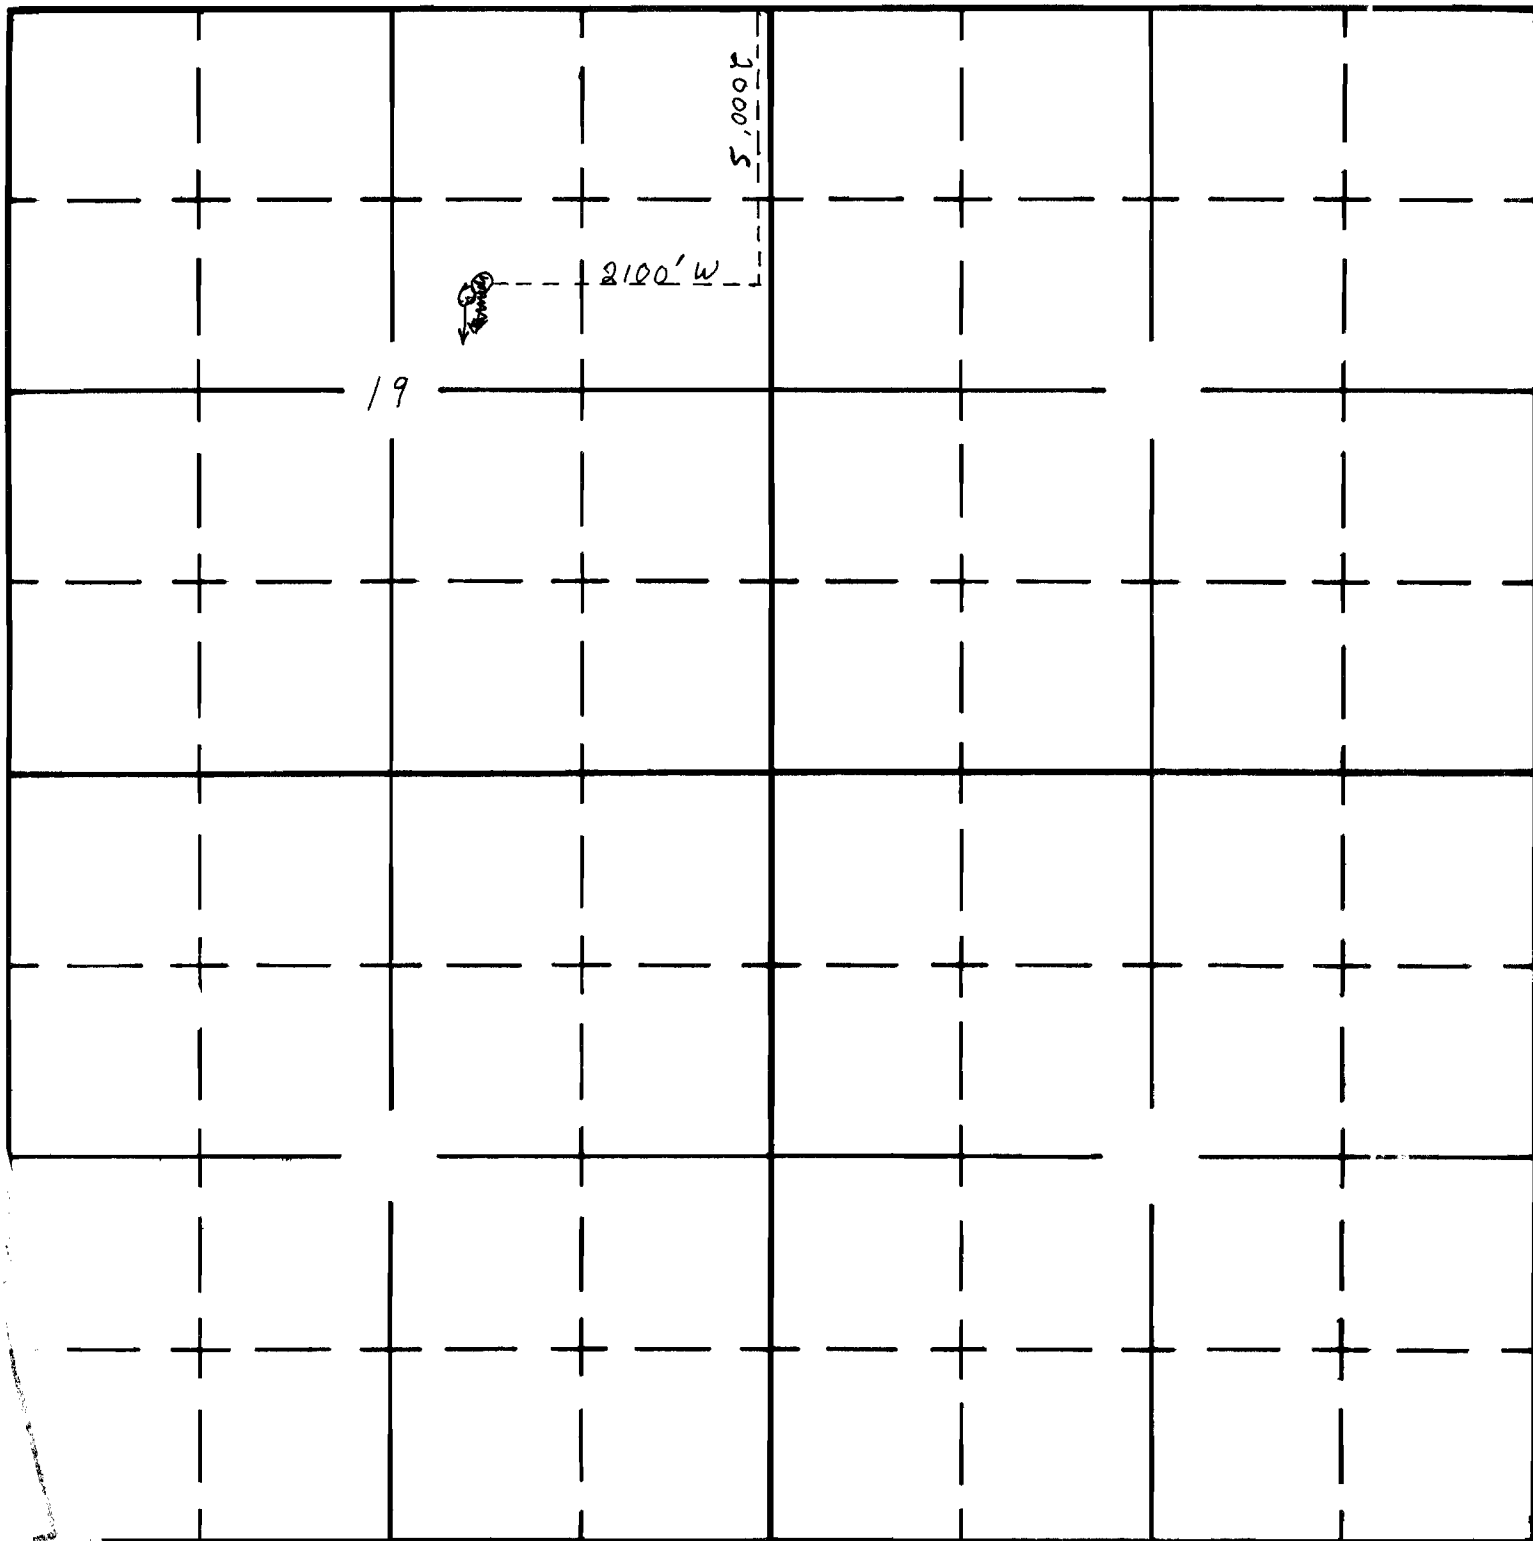

South

APPLICATION No. 37998
PERMIT No. 30197