

UNITED STATES
DEPARTMENT OF THE INTERIOR
BUREAU OF LAND MANAGEMENT


SECTION

24

Oregon State Water Filings

TOWNSHIP 12S, RANGE 41E, W. M.

North

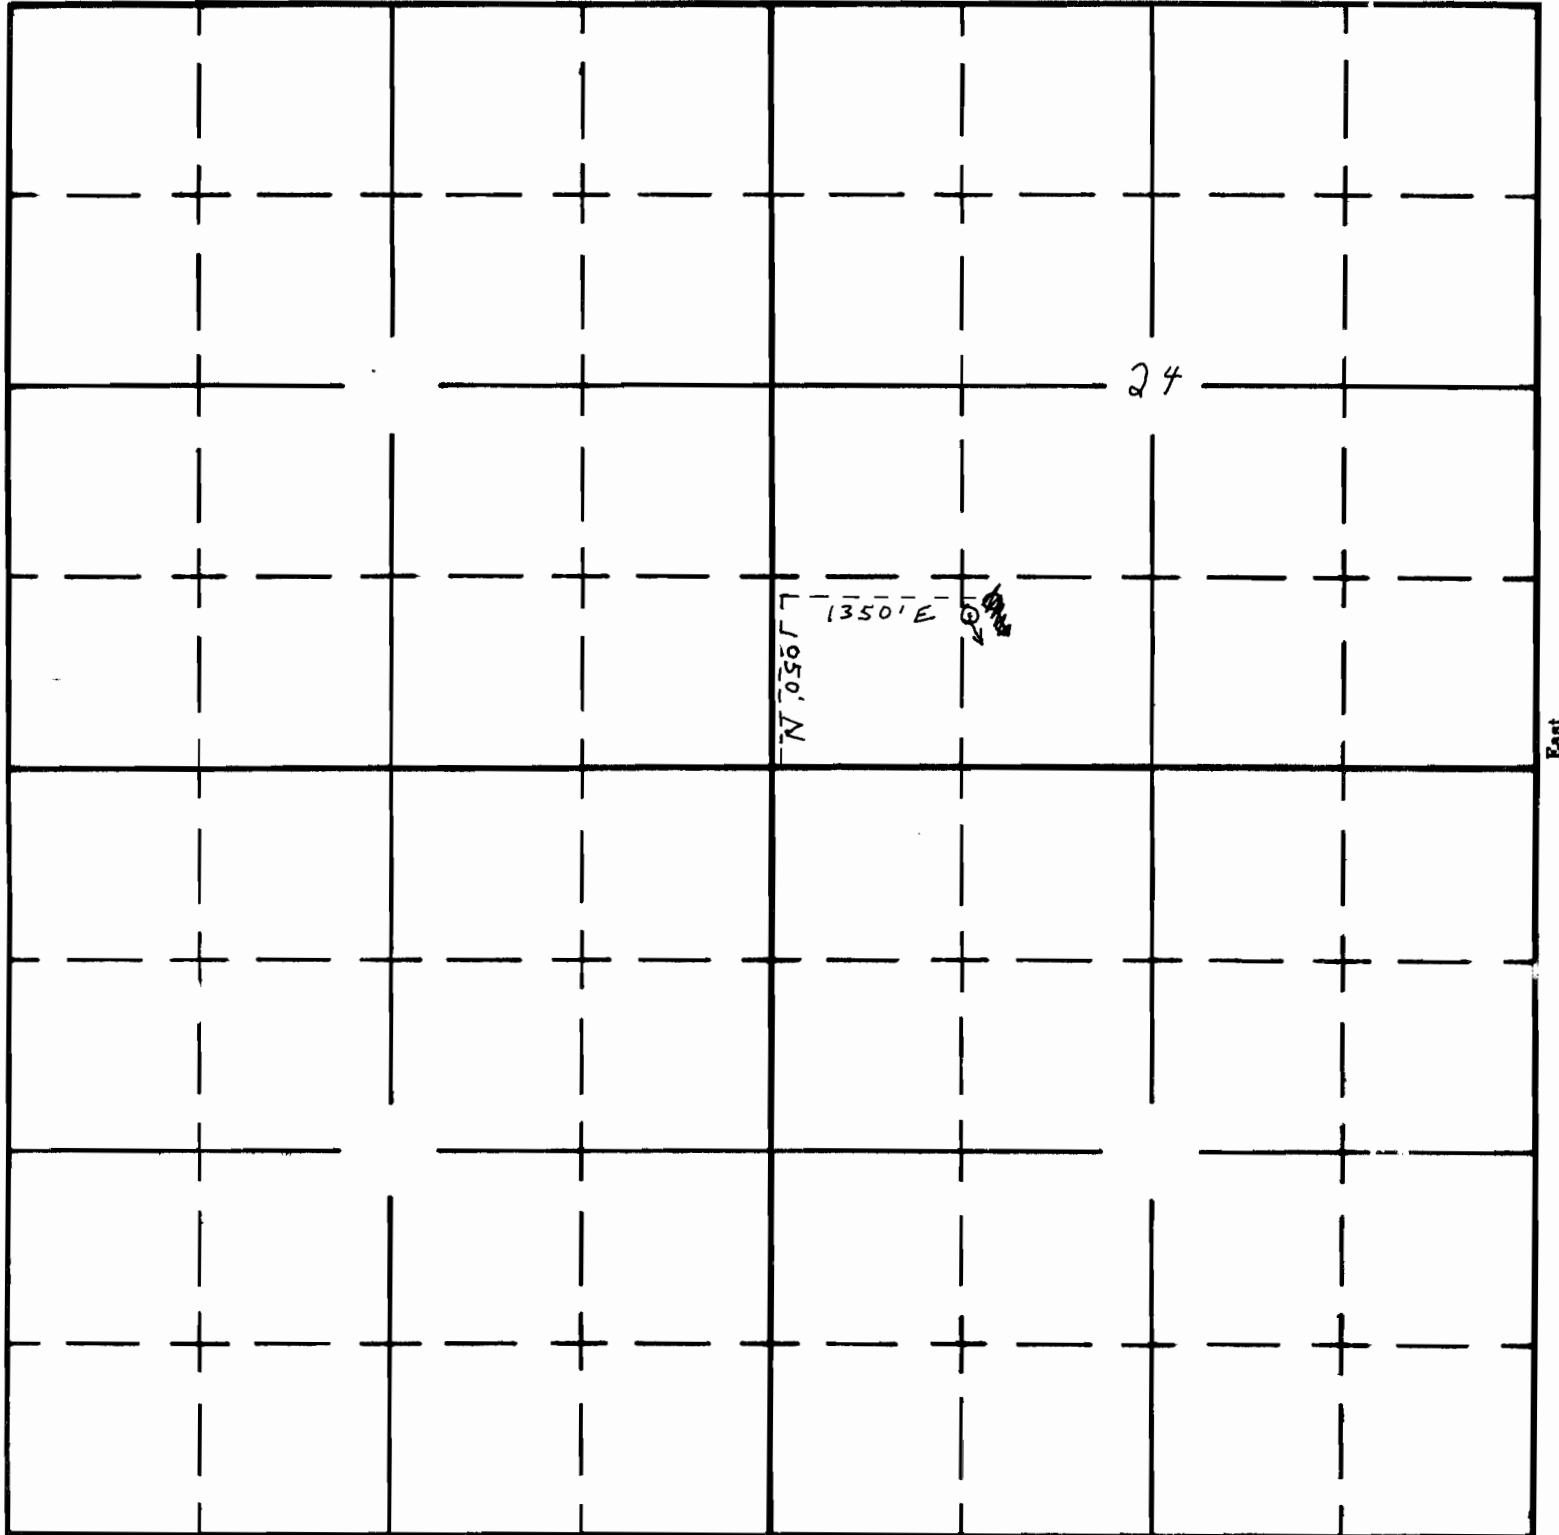

South

APPLICATION No. 38001

PERMIT No. 30200