

Form A1-187
March 1961

UNITED STATES
DEPARTMENT OF THE INTERIOR
BUREAU OF LAND MANAGEMENT

RECEIVED
MAY 1961
STATE ENGINEER
BUREAU OF LAND MANAGEMENT

SECTION


14 & 15

Oregon State Water Filings

TOWNSHIP 36S, RANGE 43E, W. M.

WILLOW SPRING

North

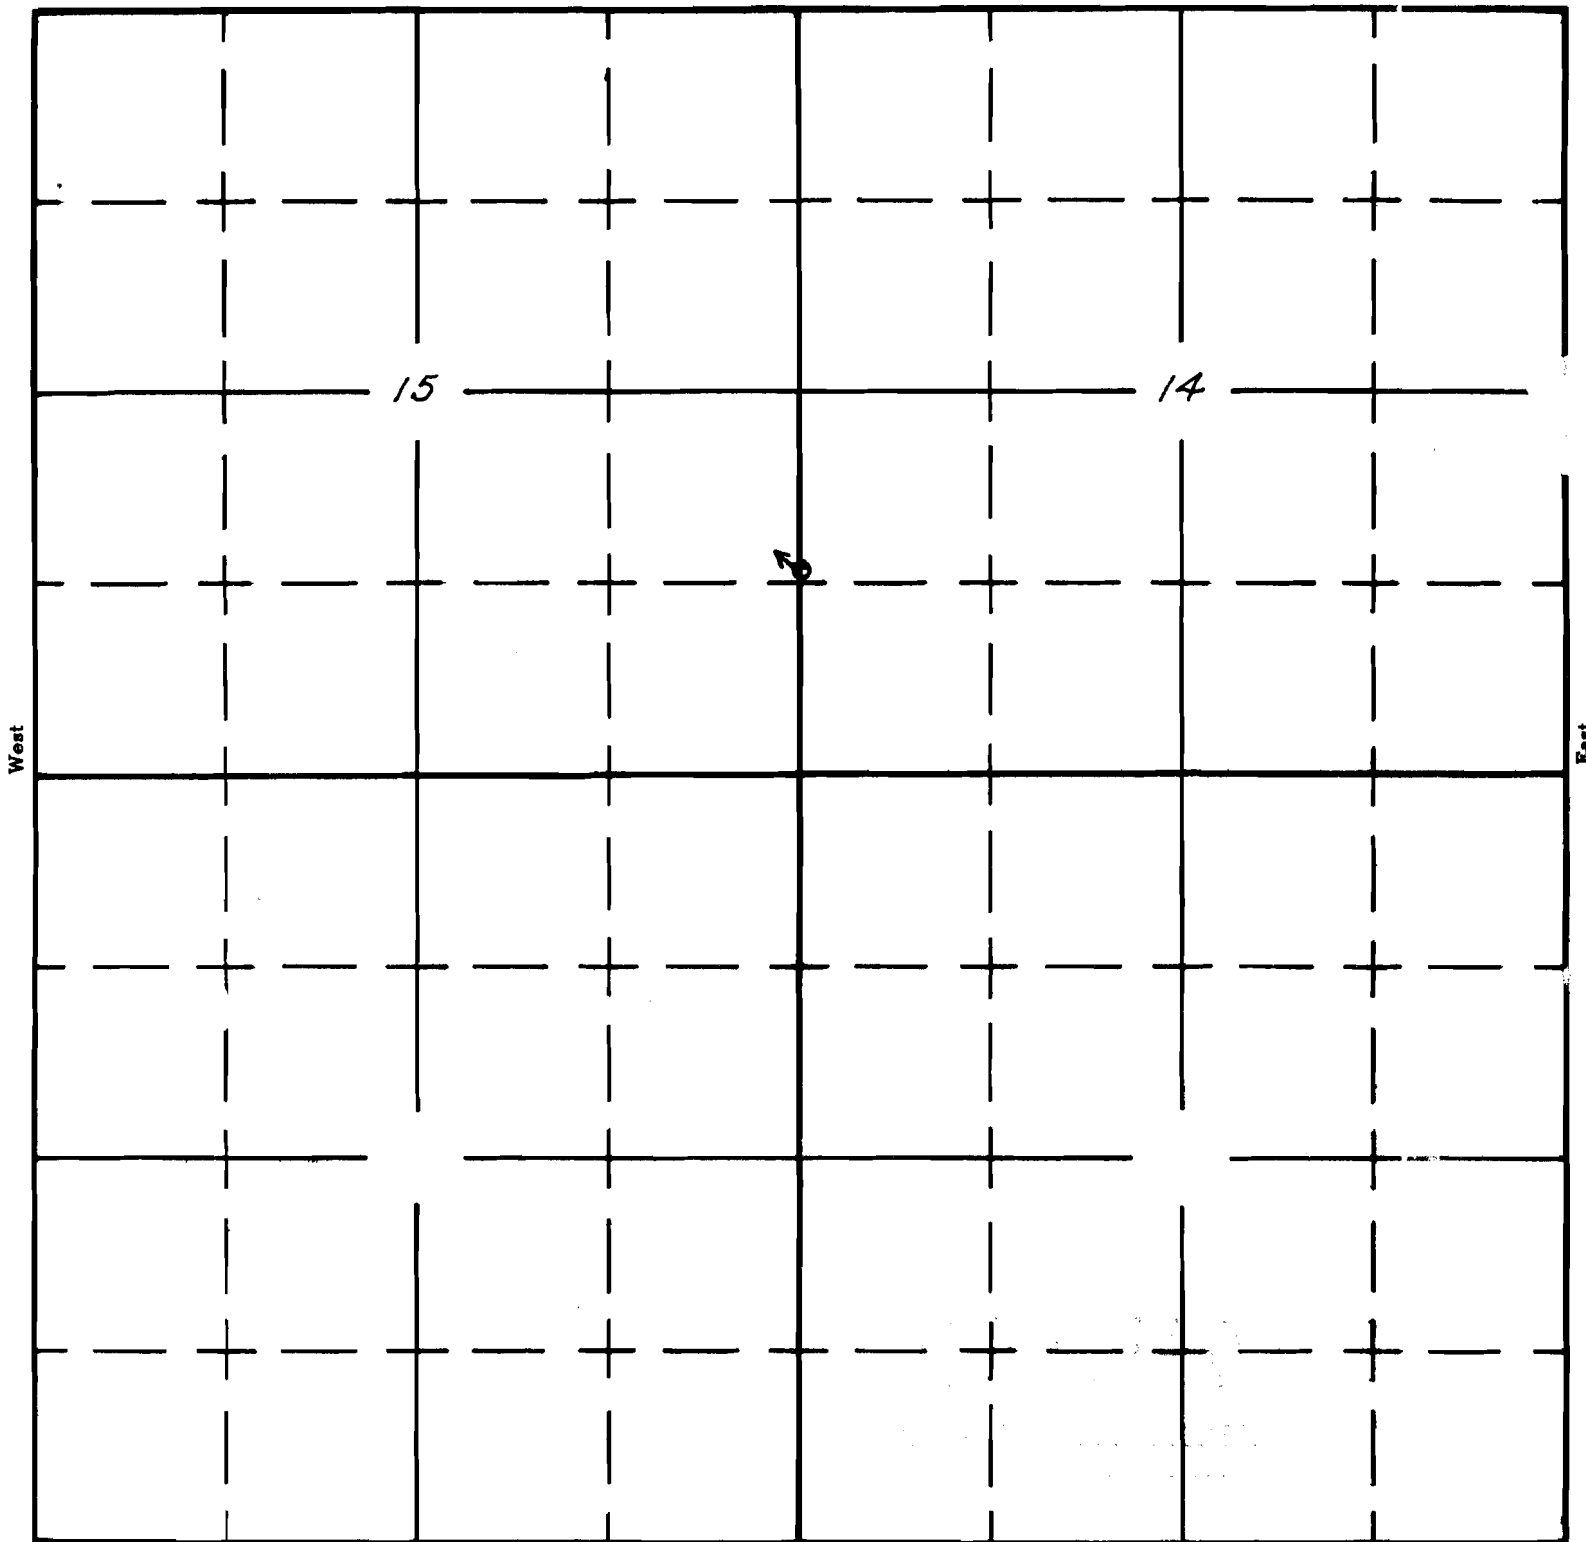

SCALE: 4" = 1 MILE

South

APPLICATION No. 40925
PERMIT No. 30534