

UNITED STATES
DEPARTMENT OF THE INTERIOR
BUREAU OF LAND MANAGEMENT

39373

71302

SECTION

5

6

7

8

Oregon State Water Filings

TOWNSHIP 33 S., RANGE 24 E. W. M.


Application No.

15-2-51807 & R-51807

North

Permit No. 39373

& R-622

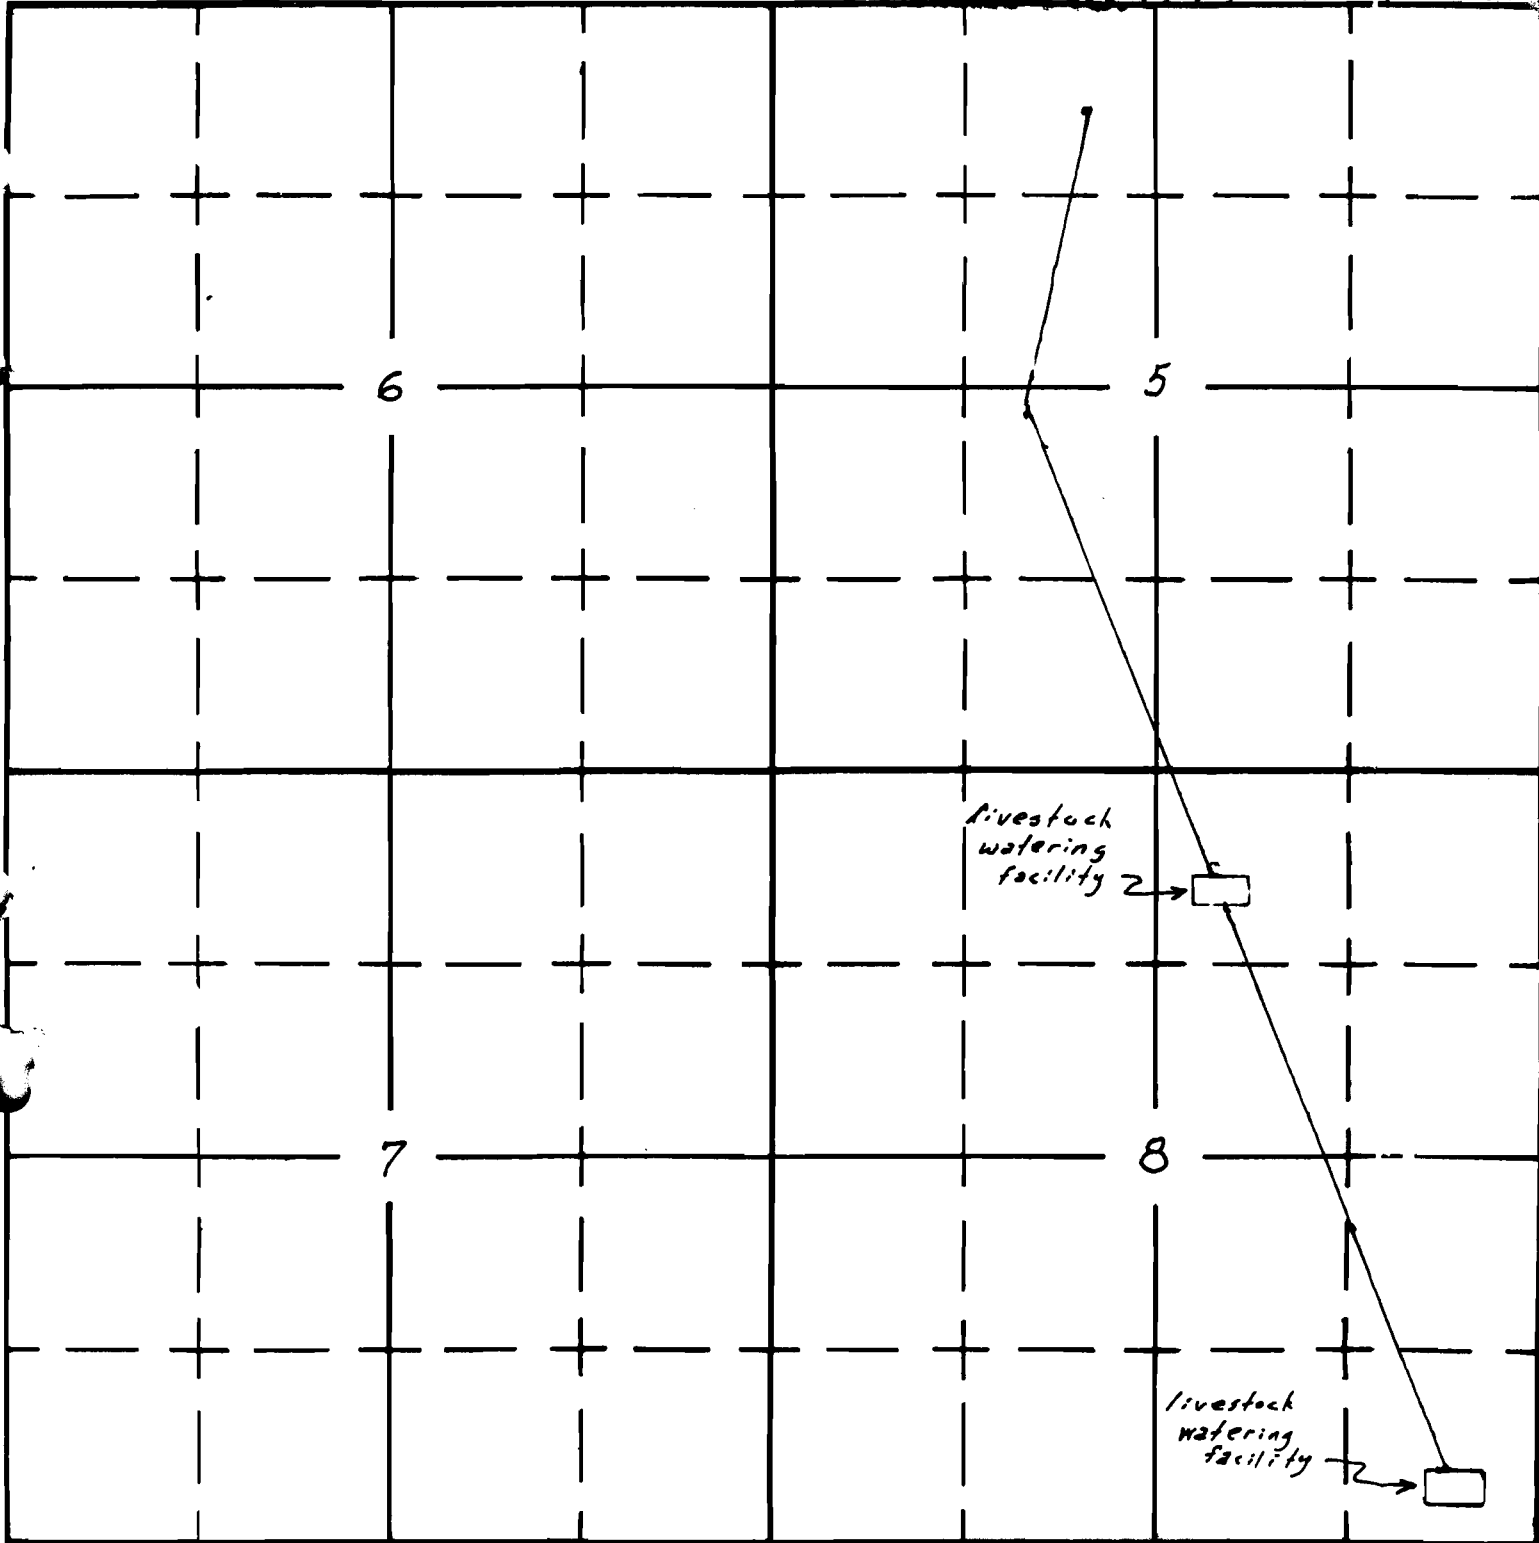

South

33-24 ✓

APPLICATION No.

PERMIT No.