

Form AI-187
March 1961

UNITED STATES
DEPARTMENT OF THE INTERIOR
BUREAU OF LAND MANAGEMENT

Application No. 56704
Permit No. 42863

SECTION 4

SE 1/4 SW 1/4

Pt. of diversion -

0 ft. N &

1350 ft. E of

SW corner, sec. 4


Oregon State Water Filings

TOWNSHIP 21 S, RANGE 35 E, W. M.

4" = 1 mile

North ↑

Sheep Spr. 01-4638

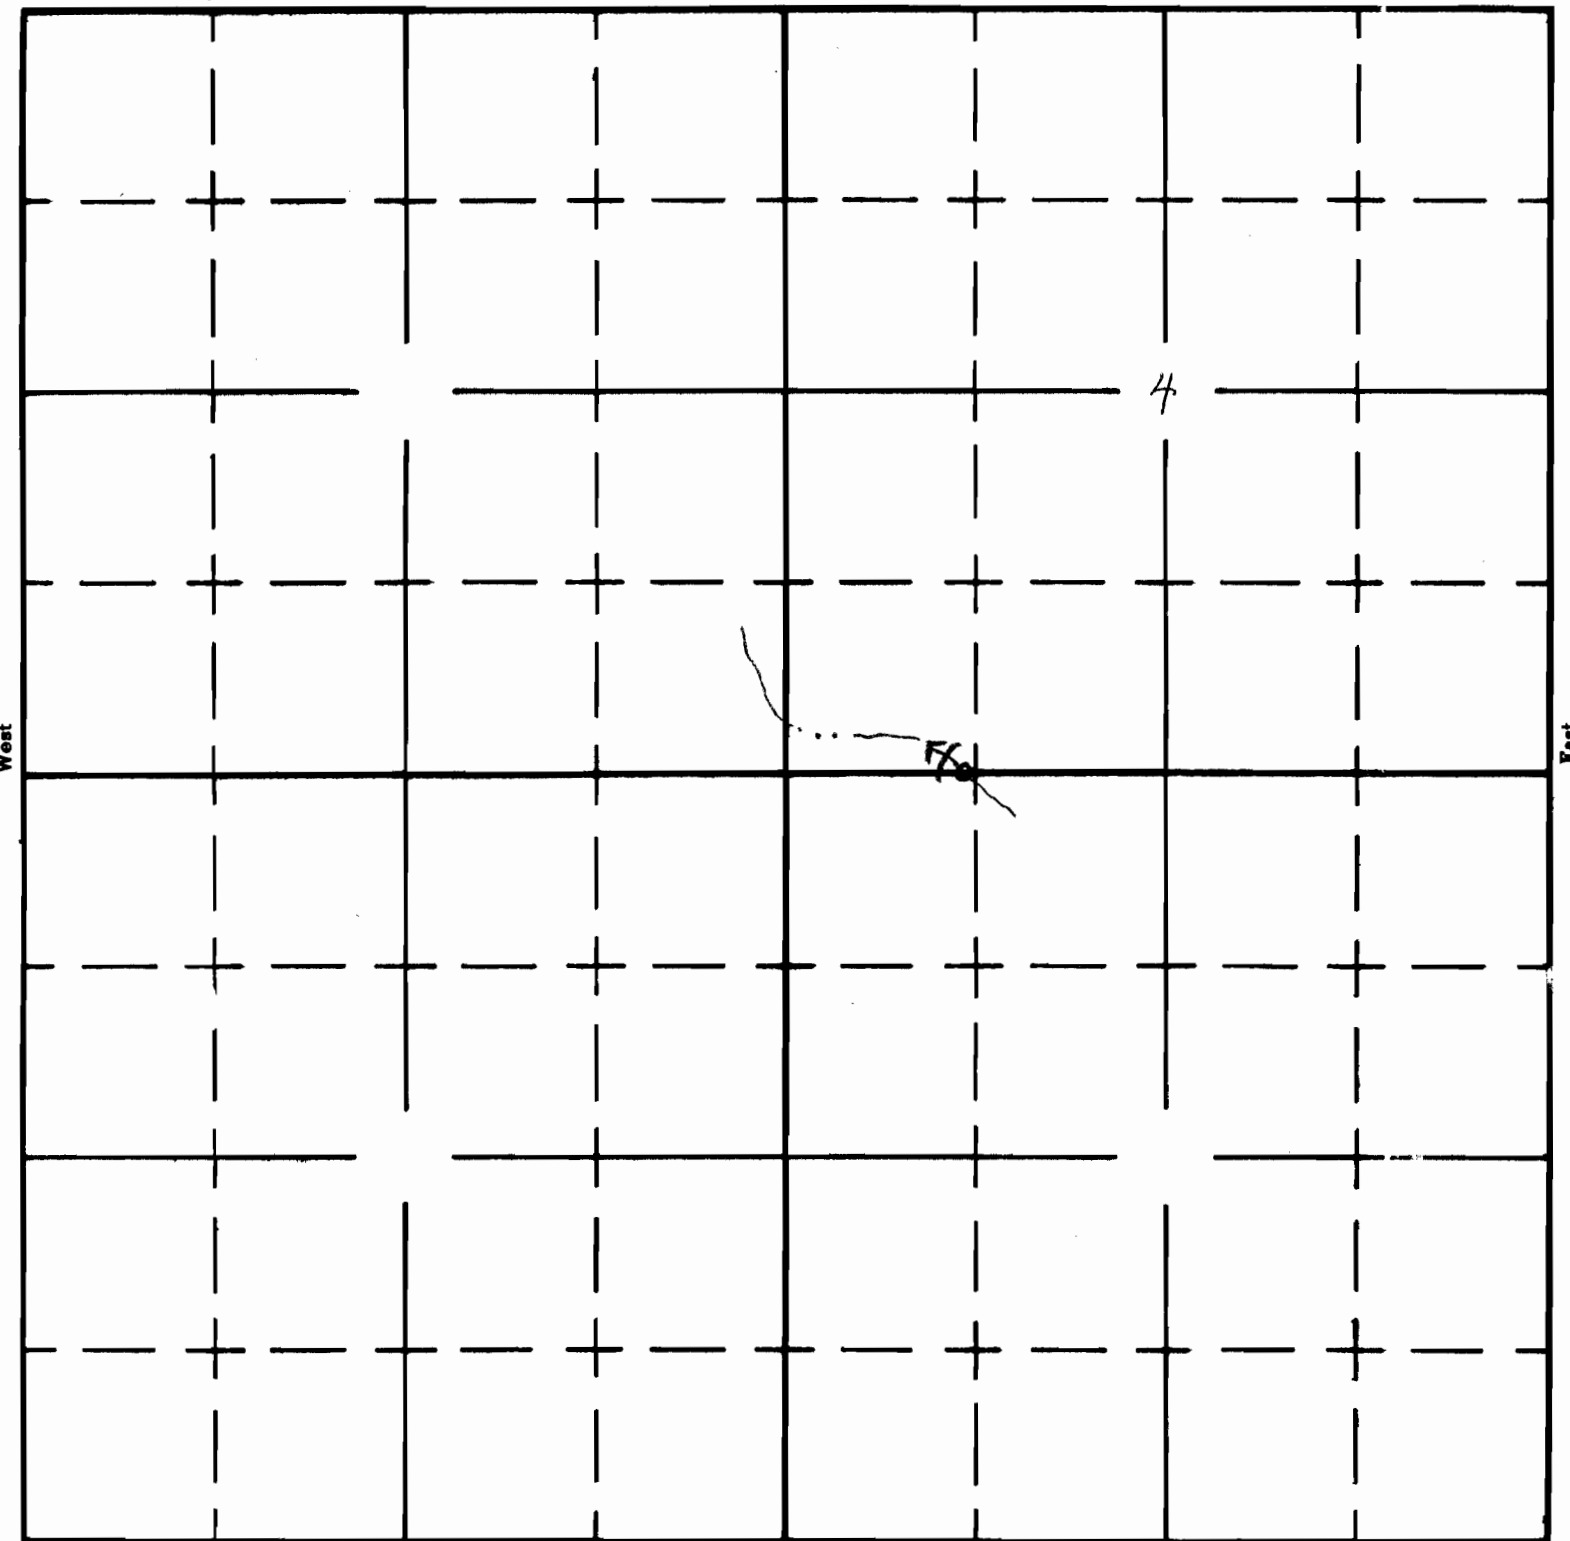

South

APPLICATION No.

PERMIT No.