

Form AI-187
March 1961

UNITED STATES
DEPARTMENT OF THE INTERIOR
BUREAU OF LAND MANAGEMENT

SECTION 25

Oregon State Water Filings


NE 1/4 NW 1/4
Pt. of diversion -
550 ft. S &
2050 ft. E of
NW corner, sec. 25

TOWNSHIP 22 S, RANGE 34 E, W. M.

4" = 1 mile

North ↑

Conley Basin Spr. 01-4634

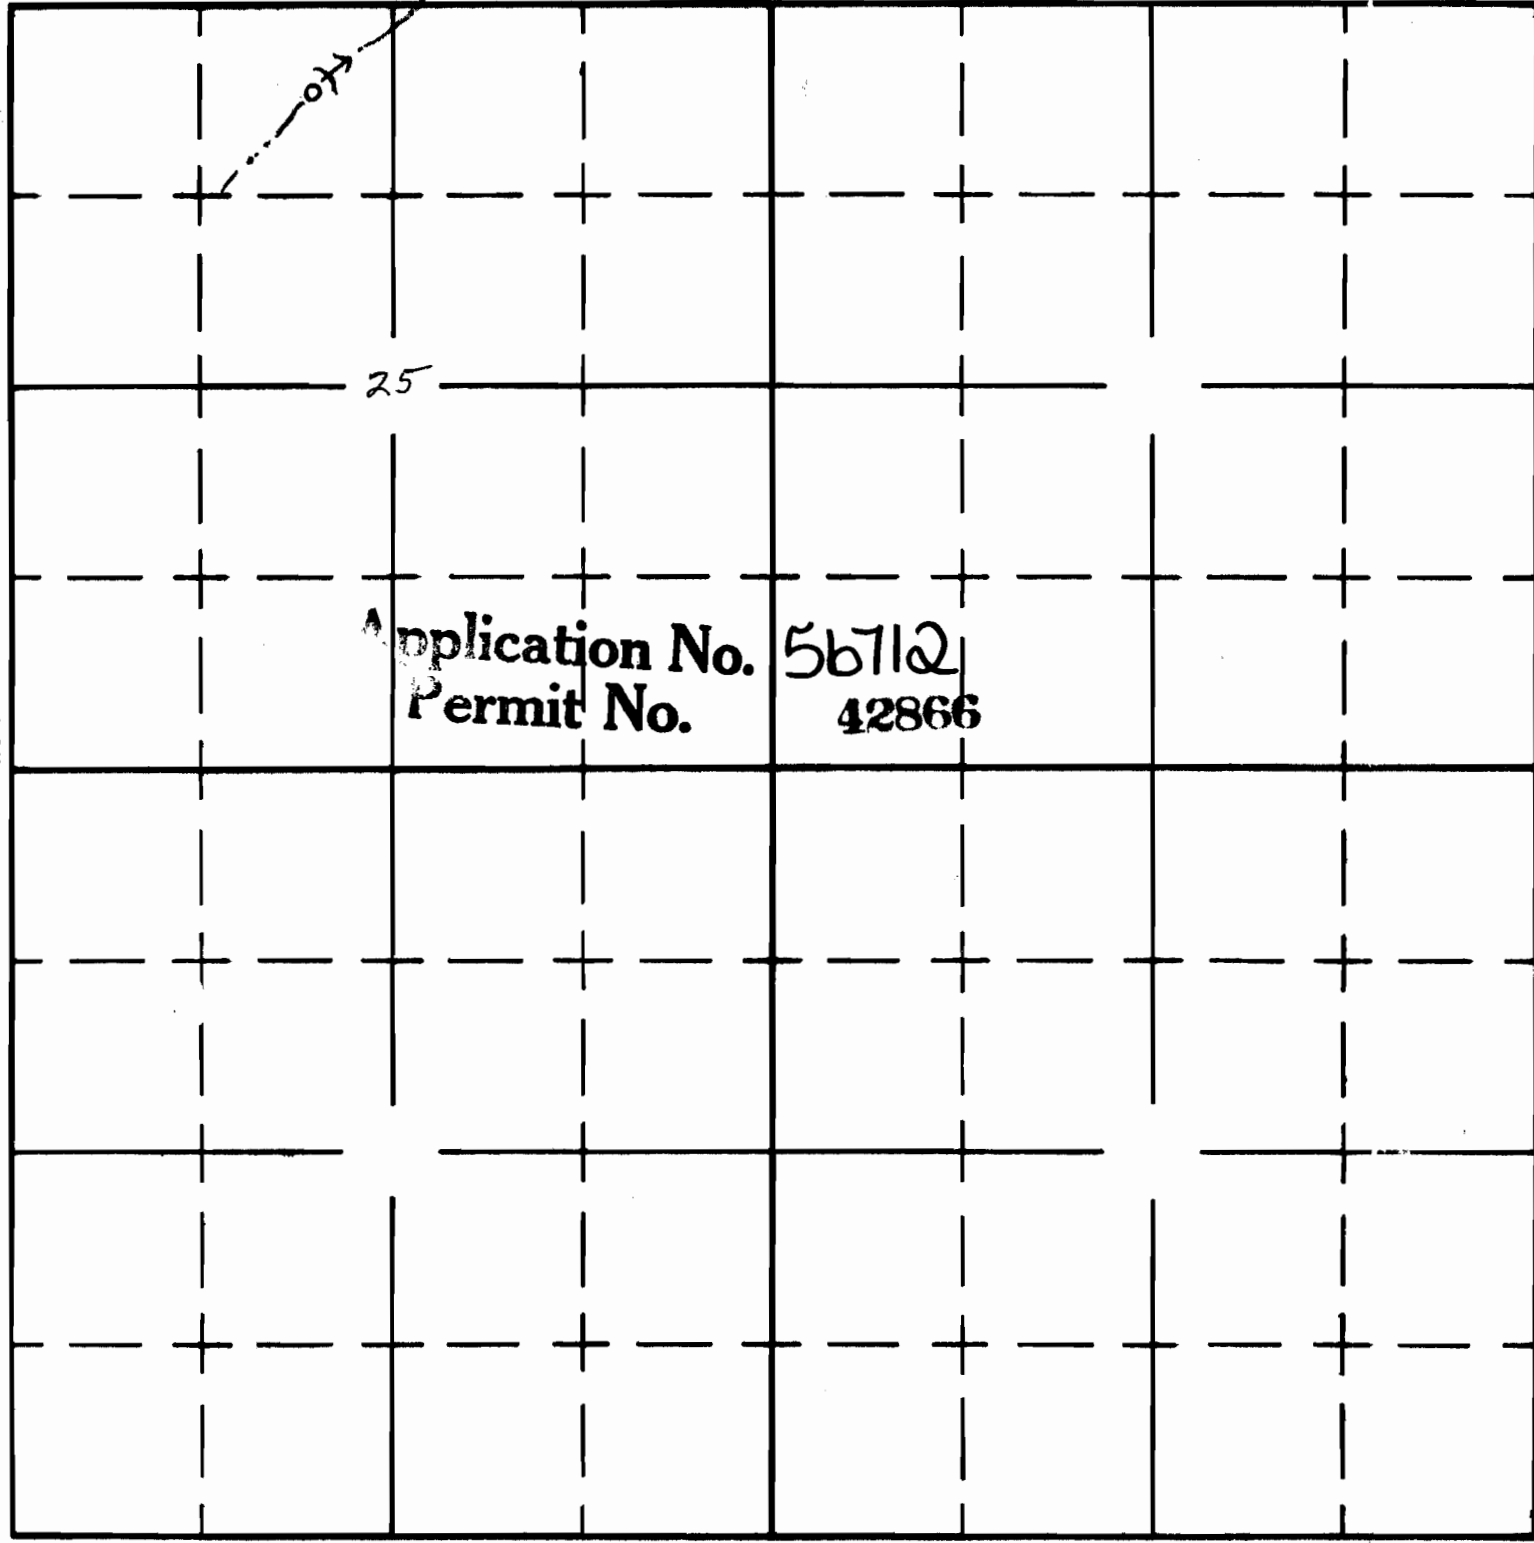

South

APPLICATION No. 56
PERMIT No.