

UNITED STATES  
DEPARTMENT OF THE INTERIOR  
BUREAU OF LAND MANAGEMENT

SECTION 5  
SW 1/4 NW 1/4



2000 ft. S &  
900 ft. E of  
NW corner, sec. 5

TOWNSHIP 24 S, RANGE 36 E, W. M.

4" = 1 mile

North ↑

Step Spr. 01-4665

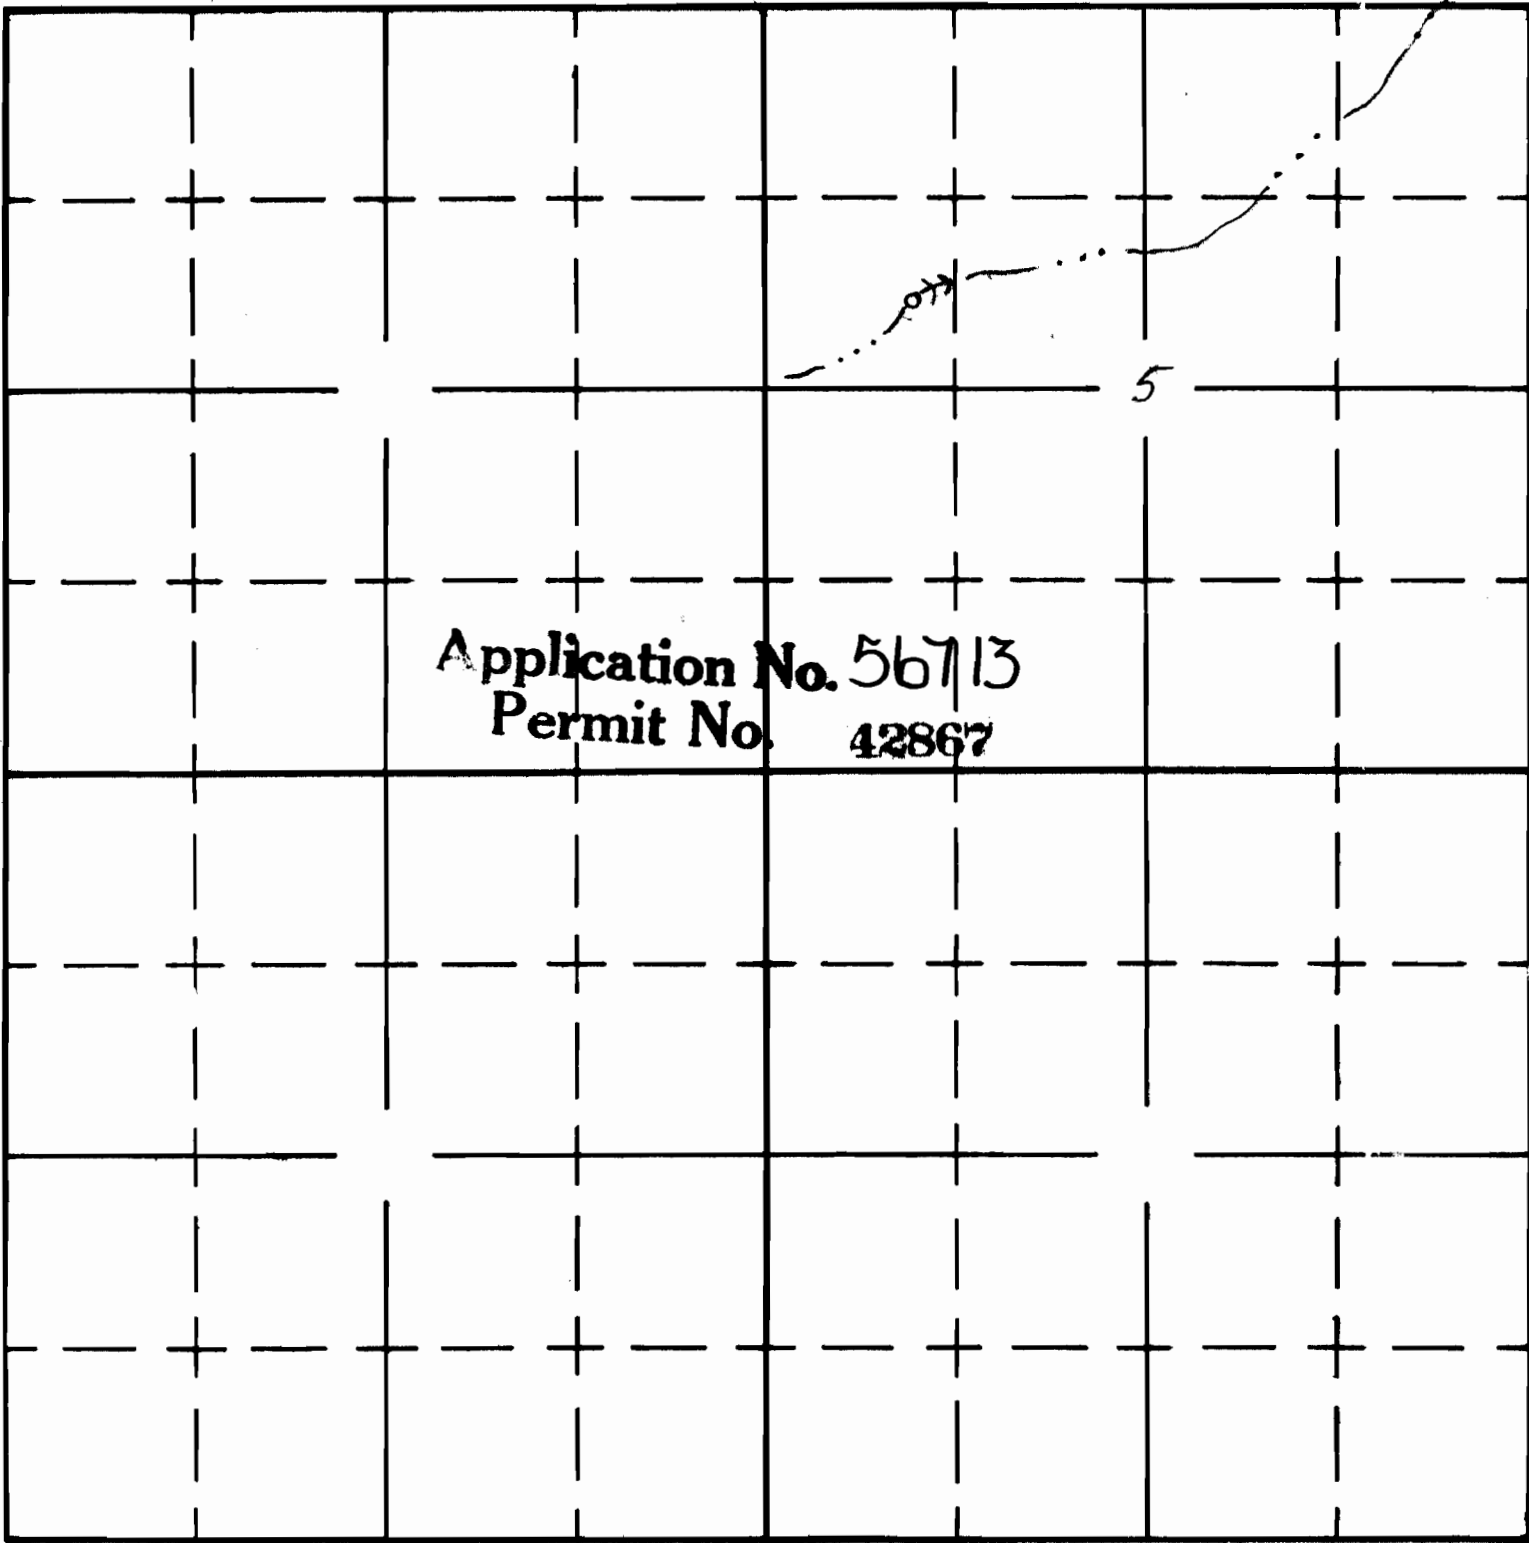

South