

Form AI-187
March 1961

UNITED STATES
DEPARTMENT OF THE INTERIOR
BUREAU OF LAND MANAGEMENT

SECTION 31

Oregon State Water Filings


NE 1/4 SW 1/4
Pt. of diversion -
1600 ft. S of
1750 ft. W of
NE corner, sec. 31

TOWNSHIP 18 S, RANGE 35 E, W. M.

4" = 1 mile

North ↑

~~Old Spr. at 1600 ft.~~
Lower Basco Spr. 01-4636

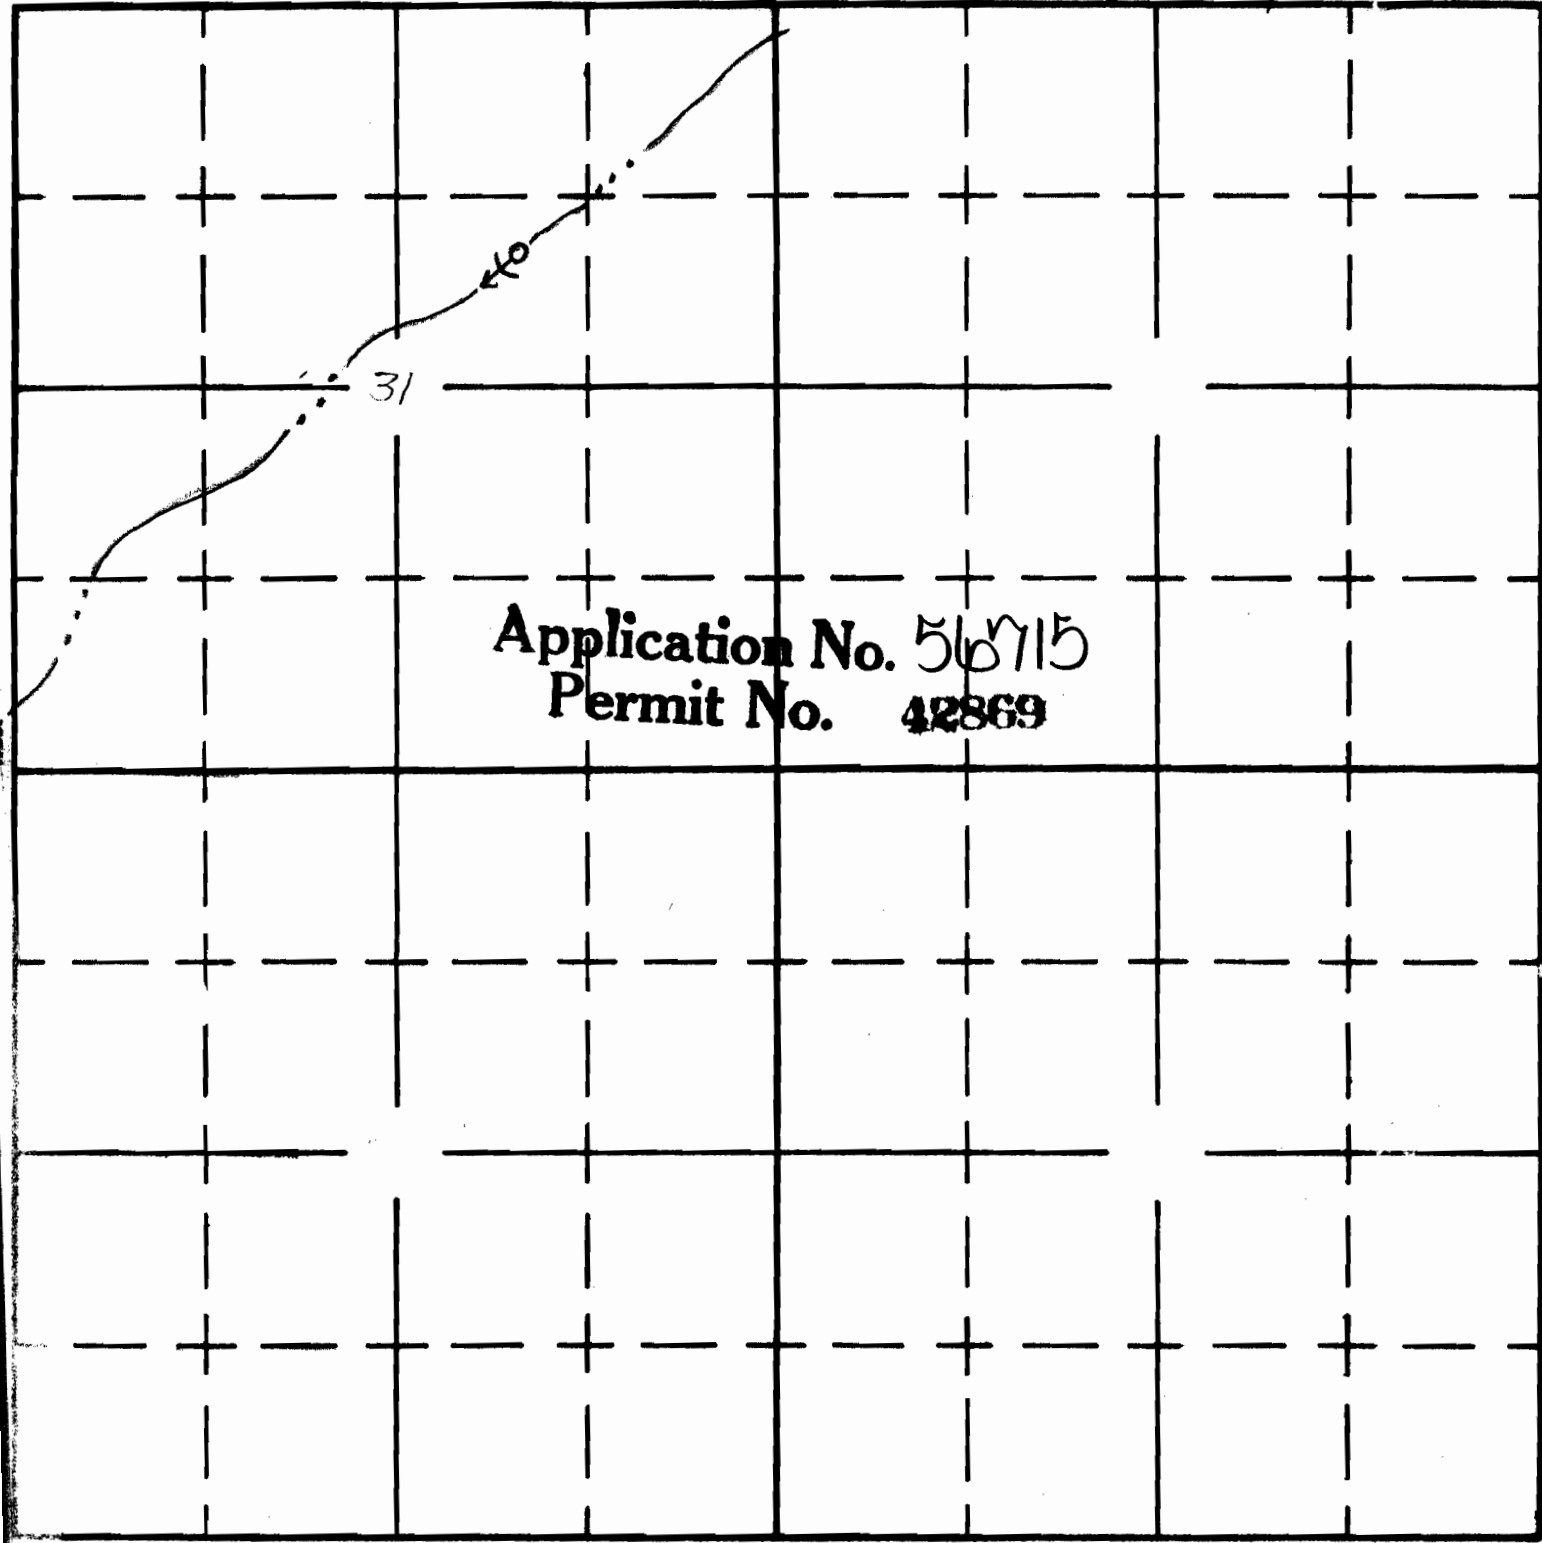

Application No. 56715
Permit No. 42869

South

APPLICATION No. 56715

PERMIT No.