

UNITED STATES
DEPARTMENT OF THE INTERIOR
BUREAU OF LAND MANAGEMENT


SECTION _____

Oregon State Water Filings

TOWNSHIP 22S, RANGE 39E, W. M.

Canyon Creek Spring #2
1/4 cor
West

North

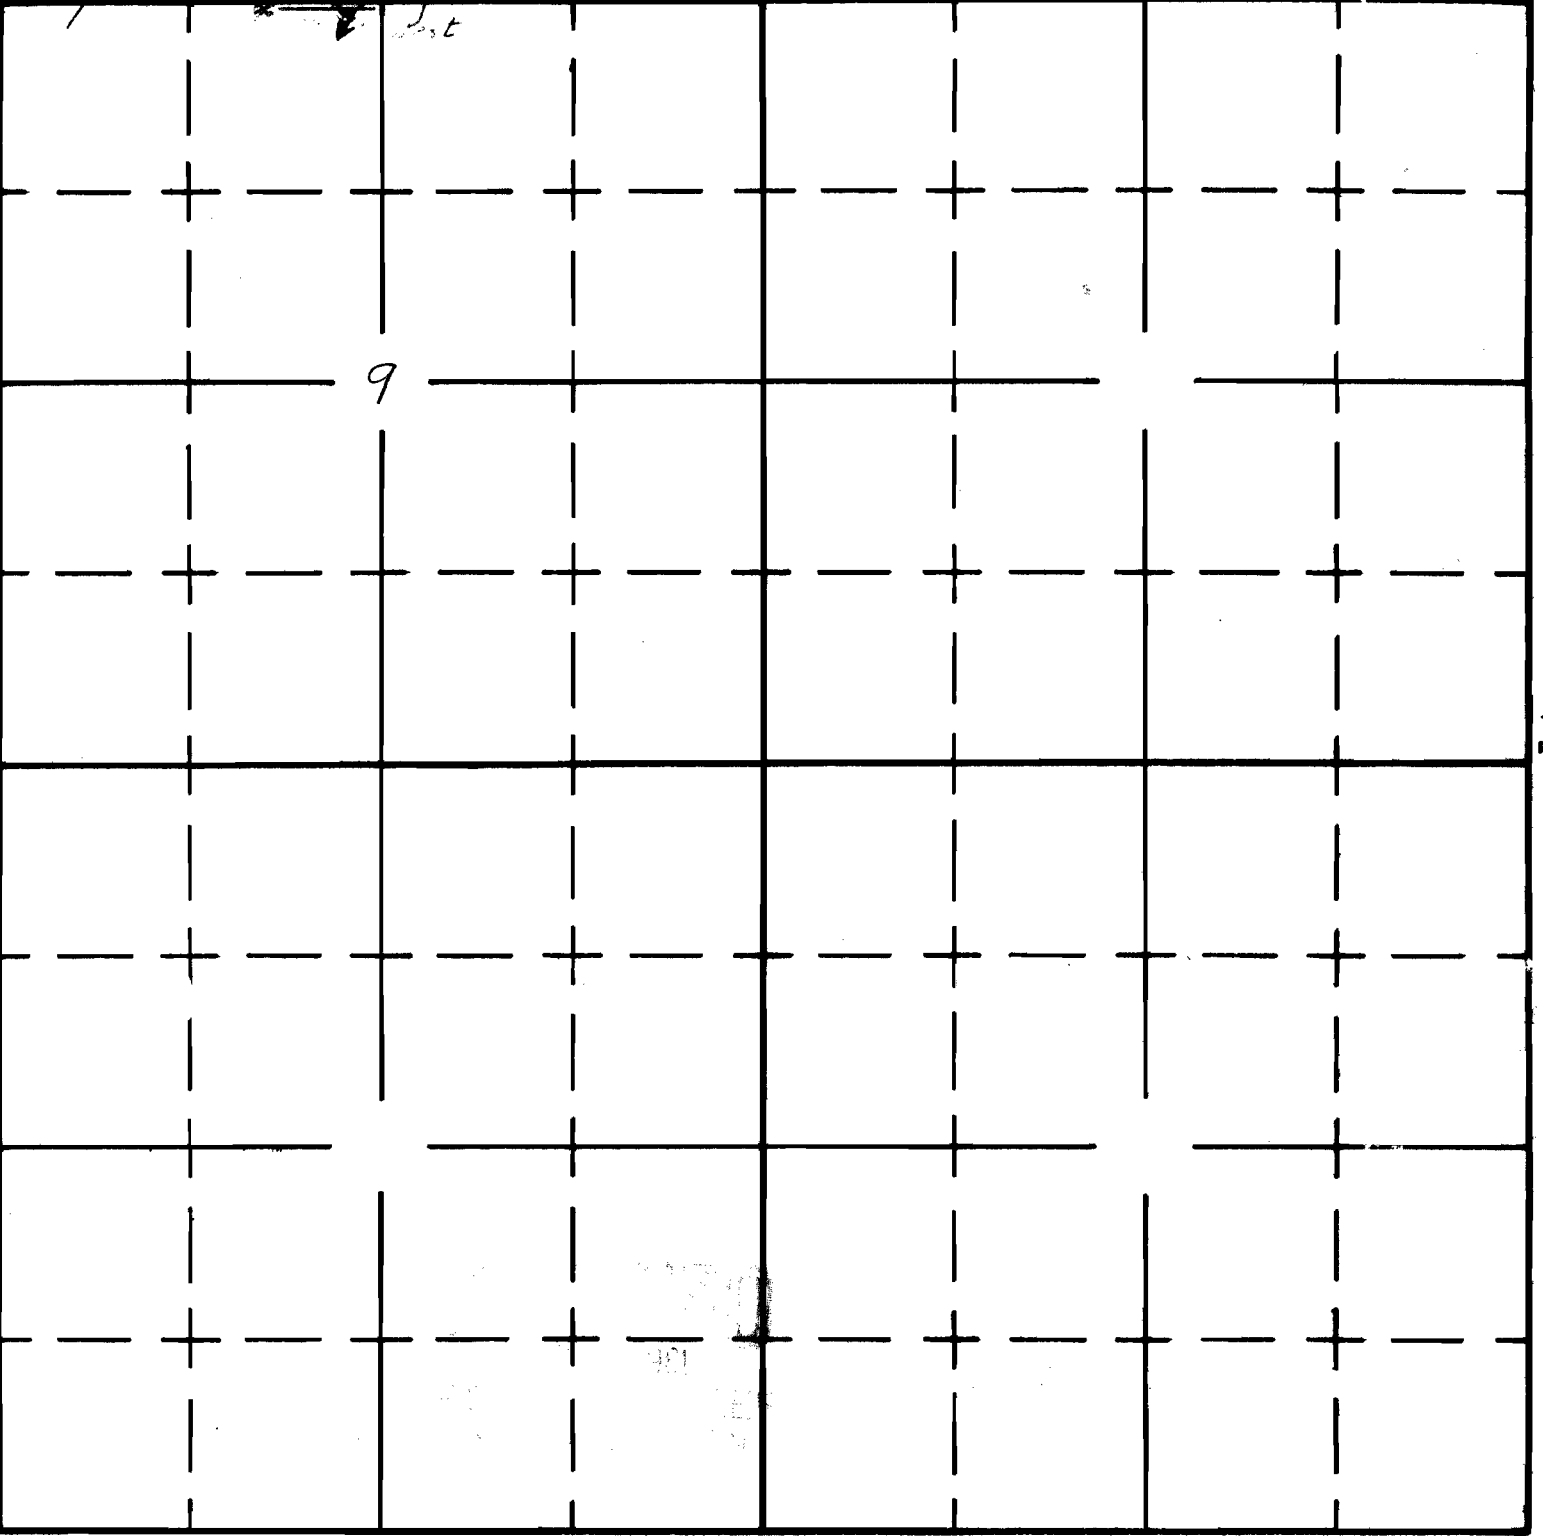

South