

UNITED STATES
DEPARTMENT OF THE INTERIOR
BUREAU OF LAND MANAGEMENT

4 Juniper Spring # 5085

SECTION

14
SE SE

Oregon State Water Filings

TOWNSHIP 24 S, RANGE 36 E, W. M.


RECEIVED


WATER RESOURCES DEPT.
SALEM, OREGON

North

Application No. 63128
Permit No. 48883

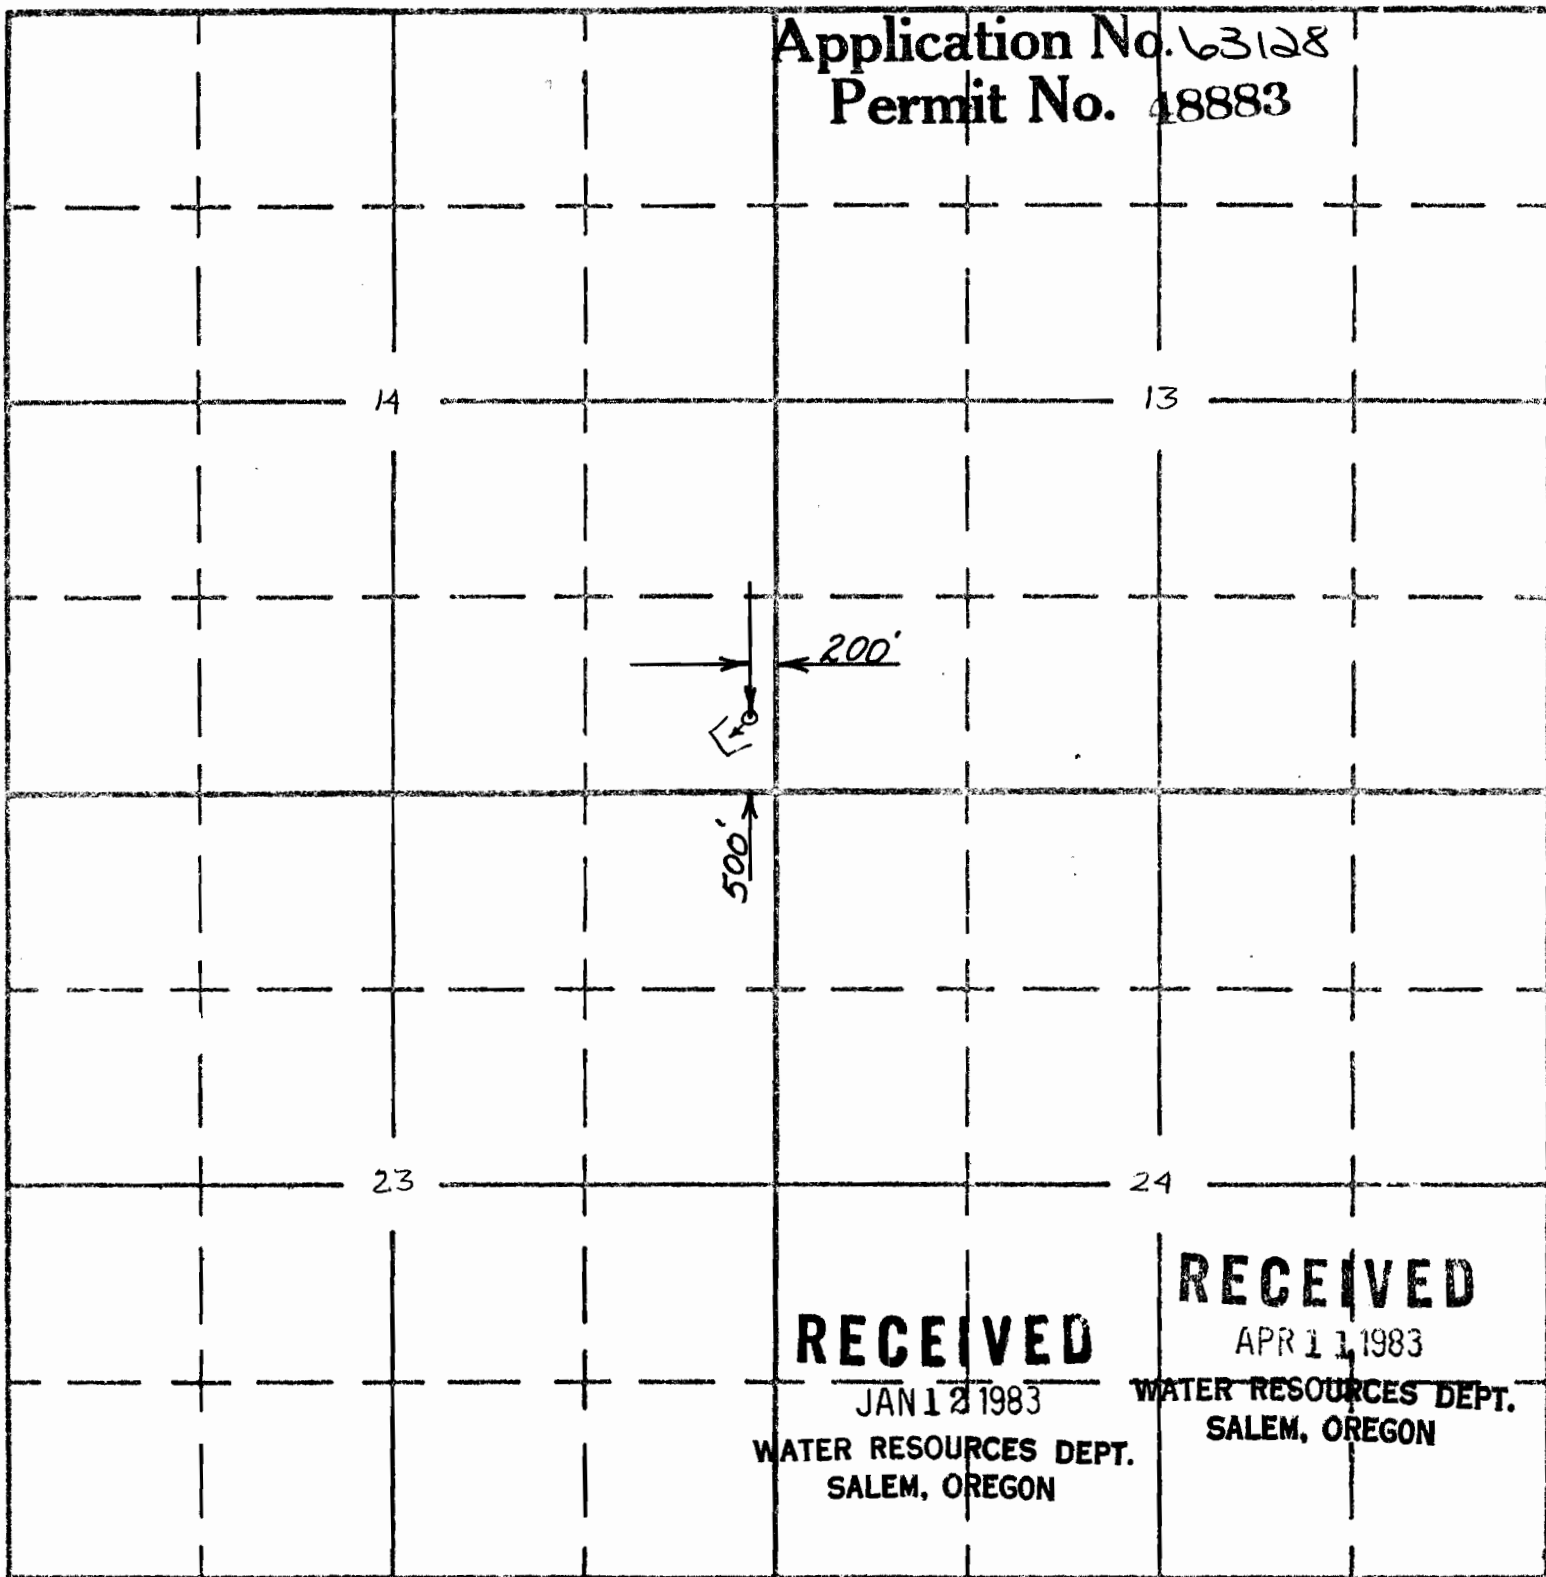

South

RECEIVED

JAN 12 1983

WATER RESOURCES DEPT.
SALEM, OREGON

RECEIVED

APR 11 1983

WATER RESOURCES DEPT.
SALEM, OREGON

APPLICATION No.

PERMIT No.