

UNITED STATES
DEPARTMENT OF THE INTERIOR
BUREAU OF LAND MANAGEMENT

SECTION 24
SWSE
8" = 1 mi

Oregon State Water Filings

TOWNSHIP 30S, RANGE 24E, W. M.


RECEIVED

OCT 18 1983

Coffee Pot Springs # 3521

North

WATER RESOURCES DEPT.
SALEM, OREGON

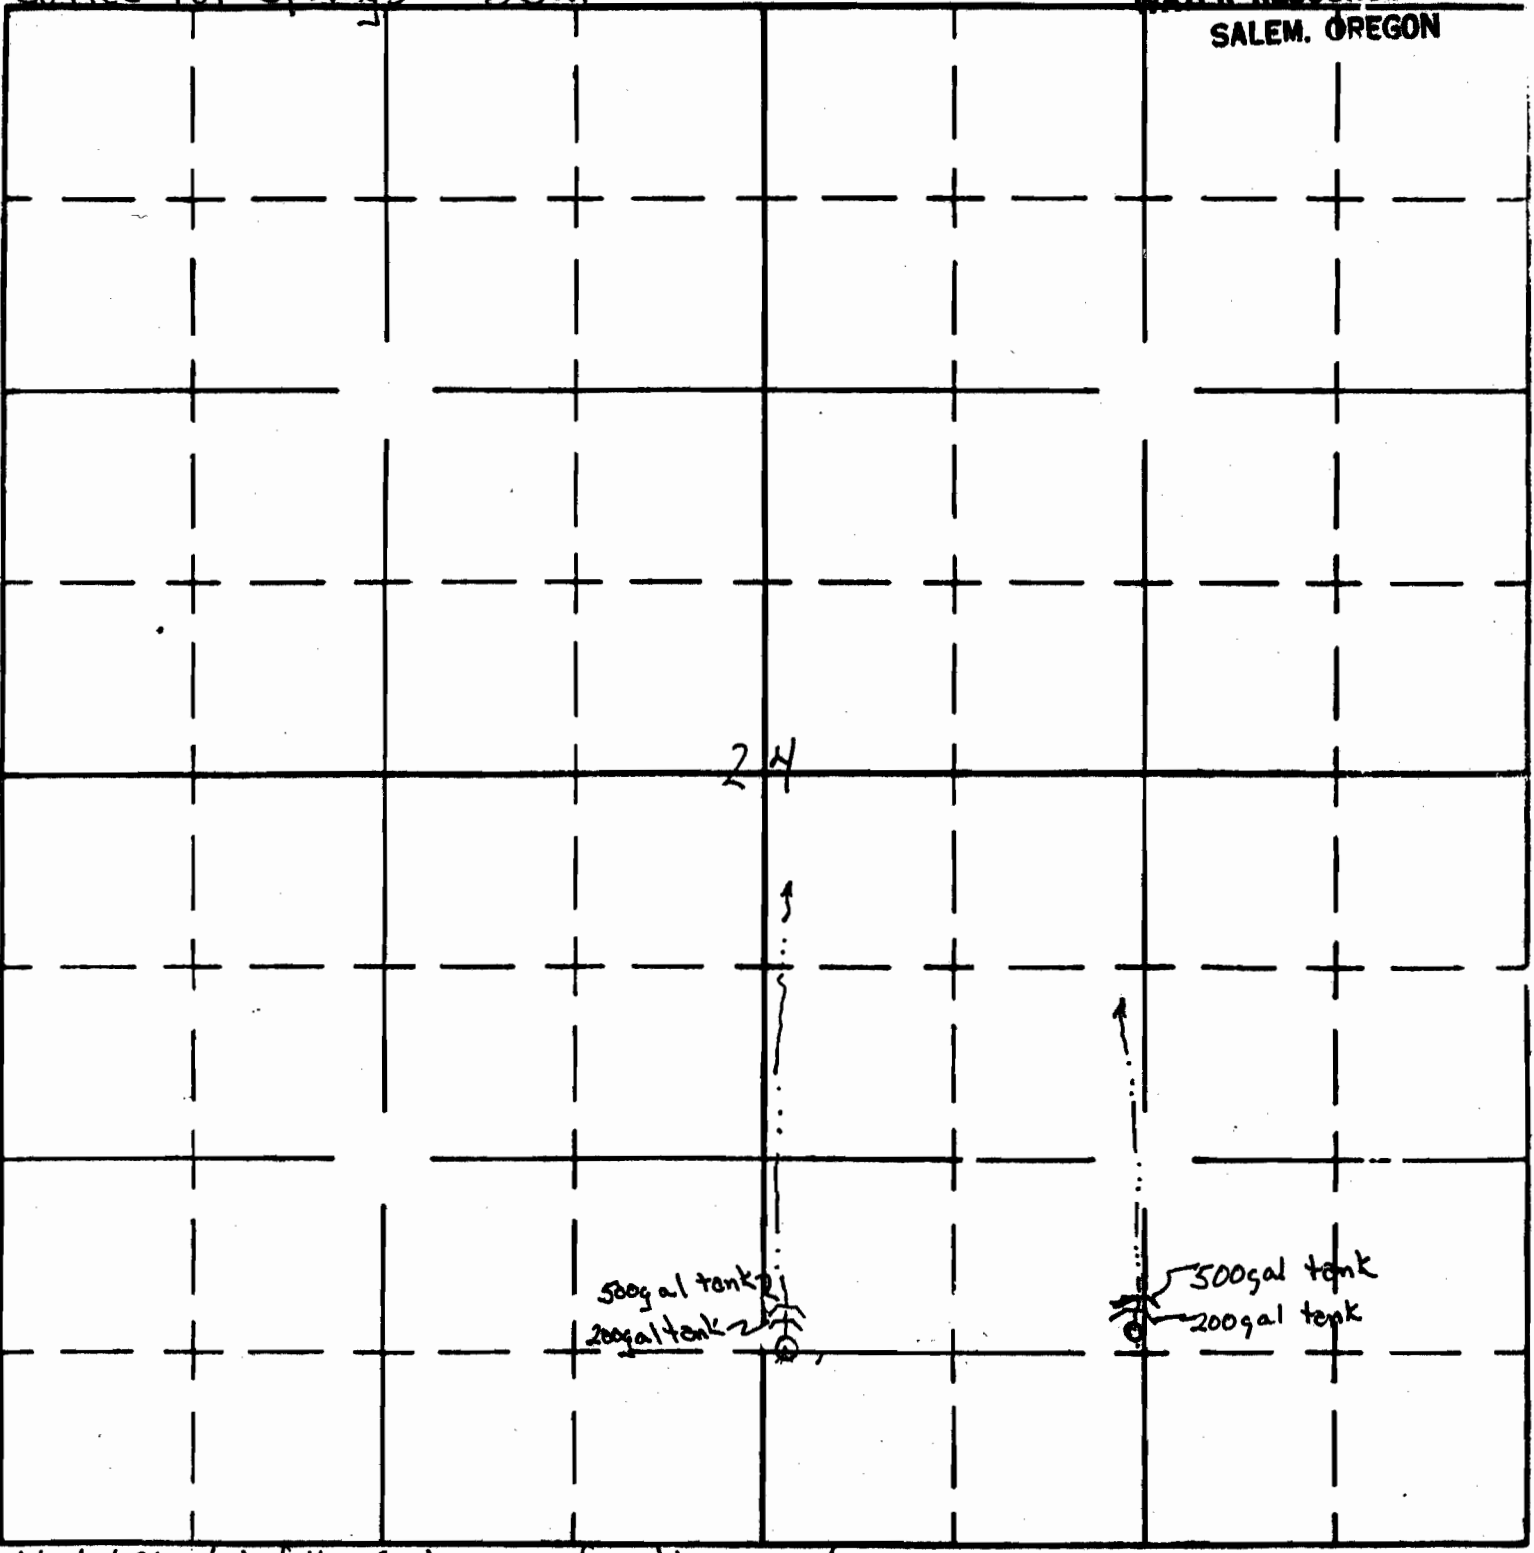

660' N 2600' W of the SW corner of section South 24
750' N 1400' W " " " " " " " "

APPLICATION No. **67677**
48889