

28

App1. No. **67682**

NE SE


Range 29E

Permit No. **48894**

$H'' = 1 \text{ Mile}$

Will. Mer.

North Highland Spring #4039

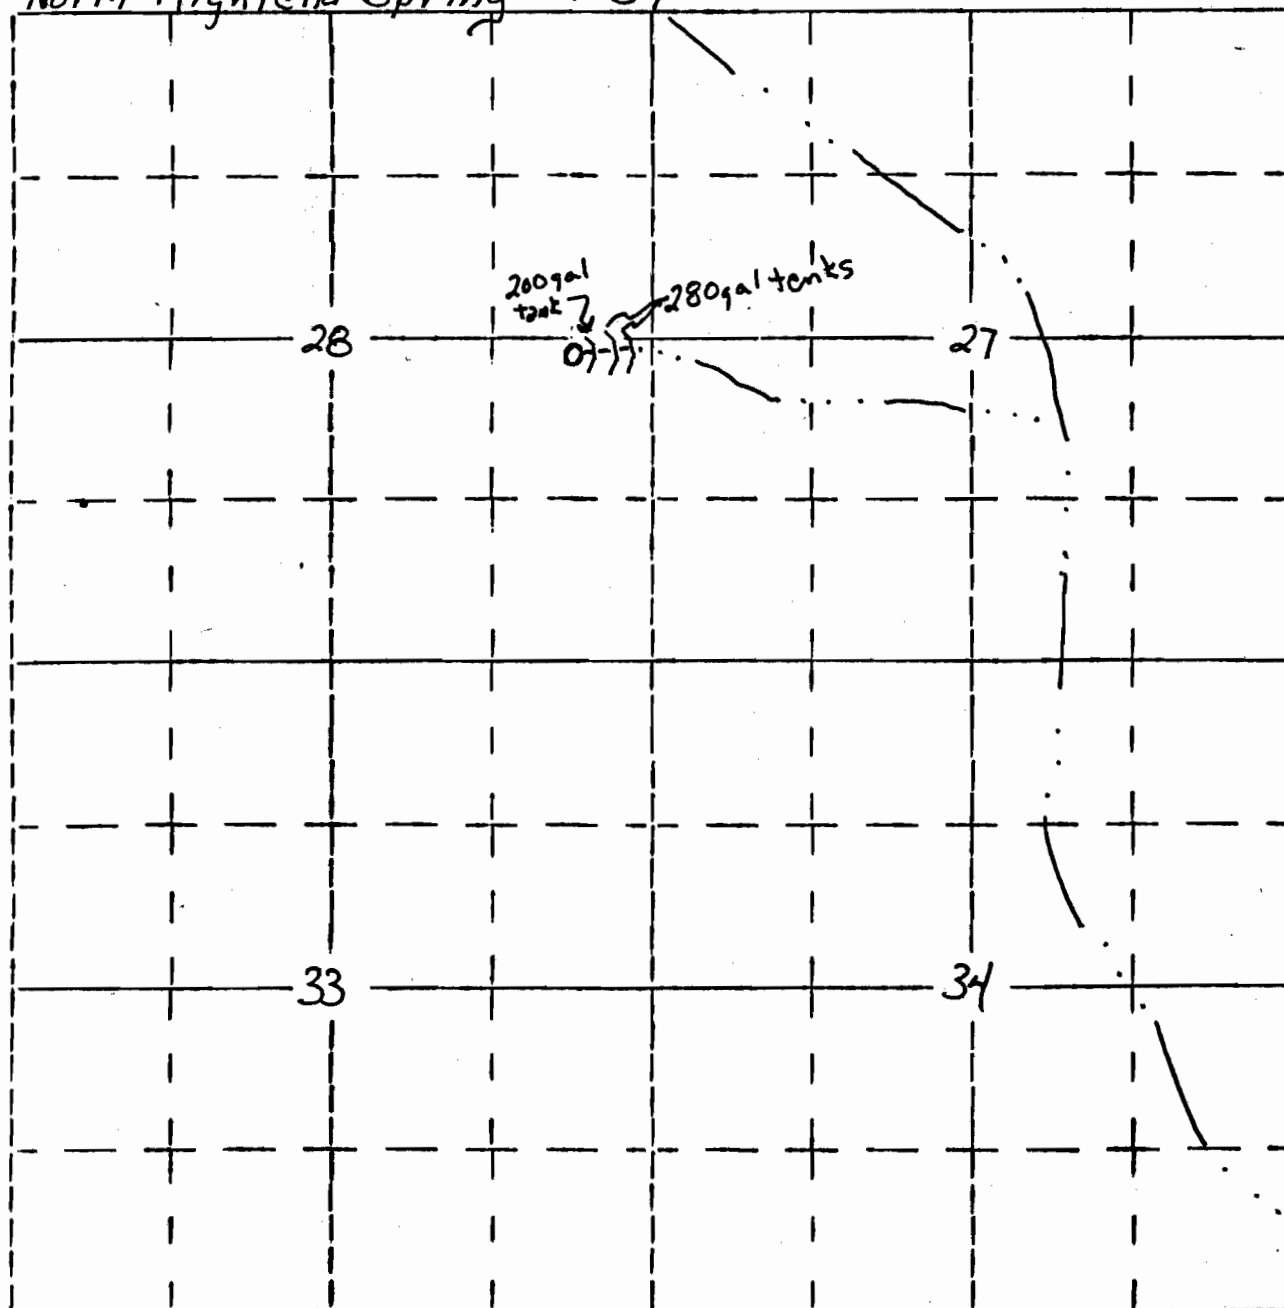

2600'N 550'W of the SE corner of section 28

RECEIVED

OCT 13 1983

**WATER RESOURCES DEPT.
SALEM, OREGON**