

Form A1-187
March 1961

UNITED STATES
DEPARTMENT OF THE INTERIOR
BUREAU OF LAND MANAGEMENT

RECEIVED

OCT 13 1983

WATER RESOURCES DEPT
SALEM, OREGON


SECTION 21
NESW
8"=1m.

Oregon State Water Filings

TOWNSHIP 38S, RANGE 23E, W. M.

BPA Spring 4370

North

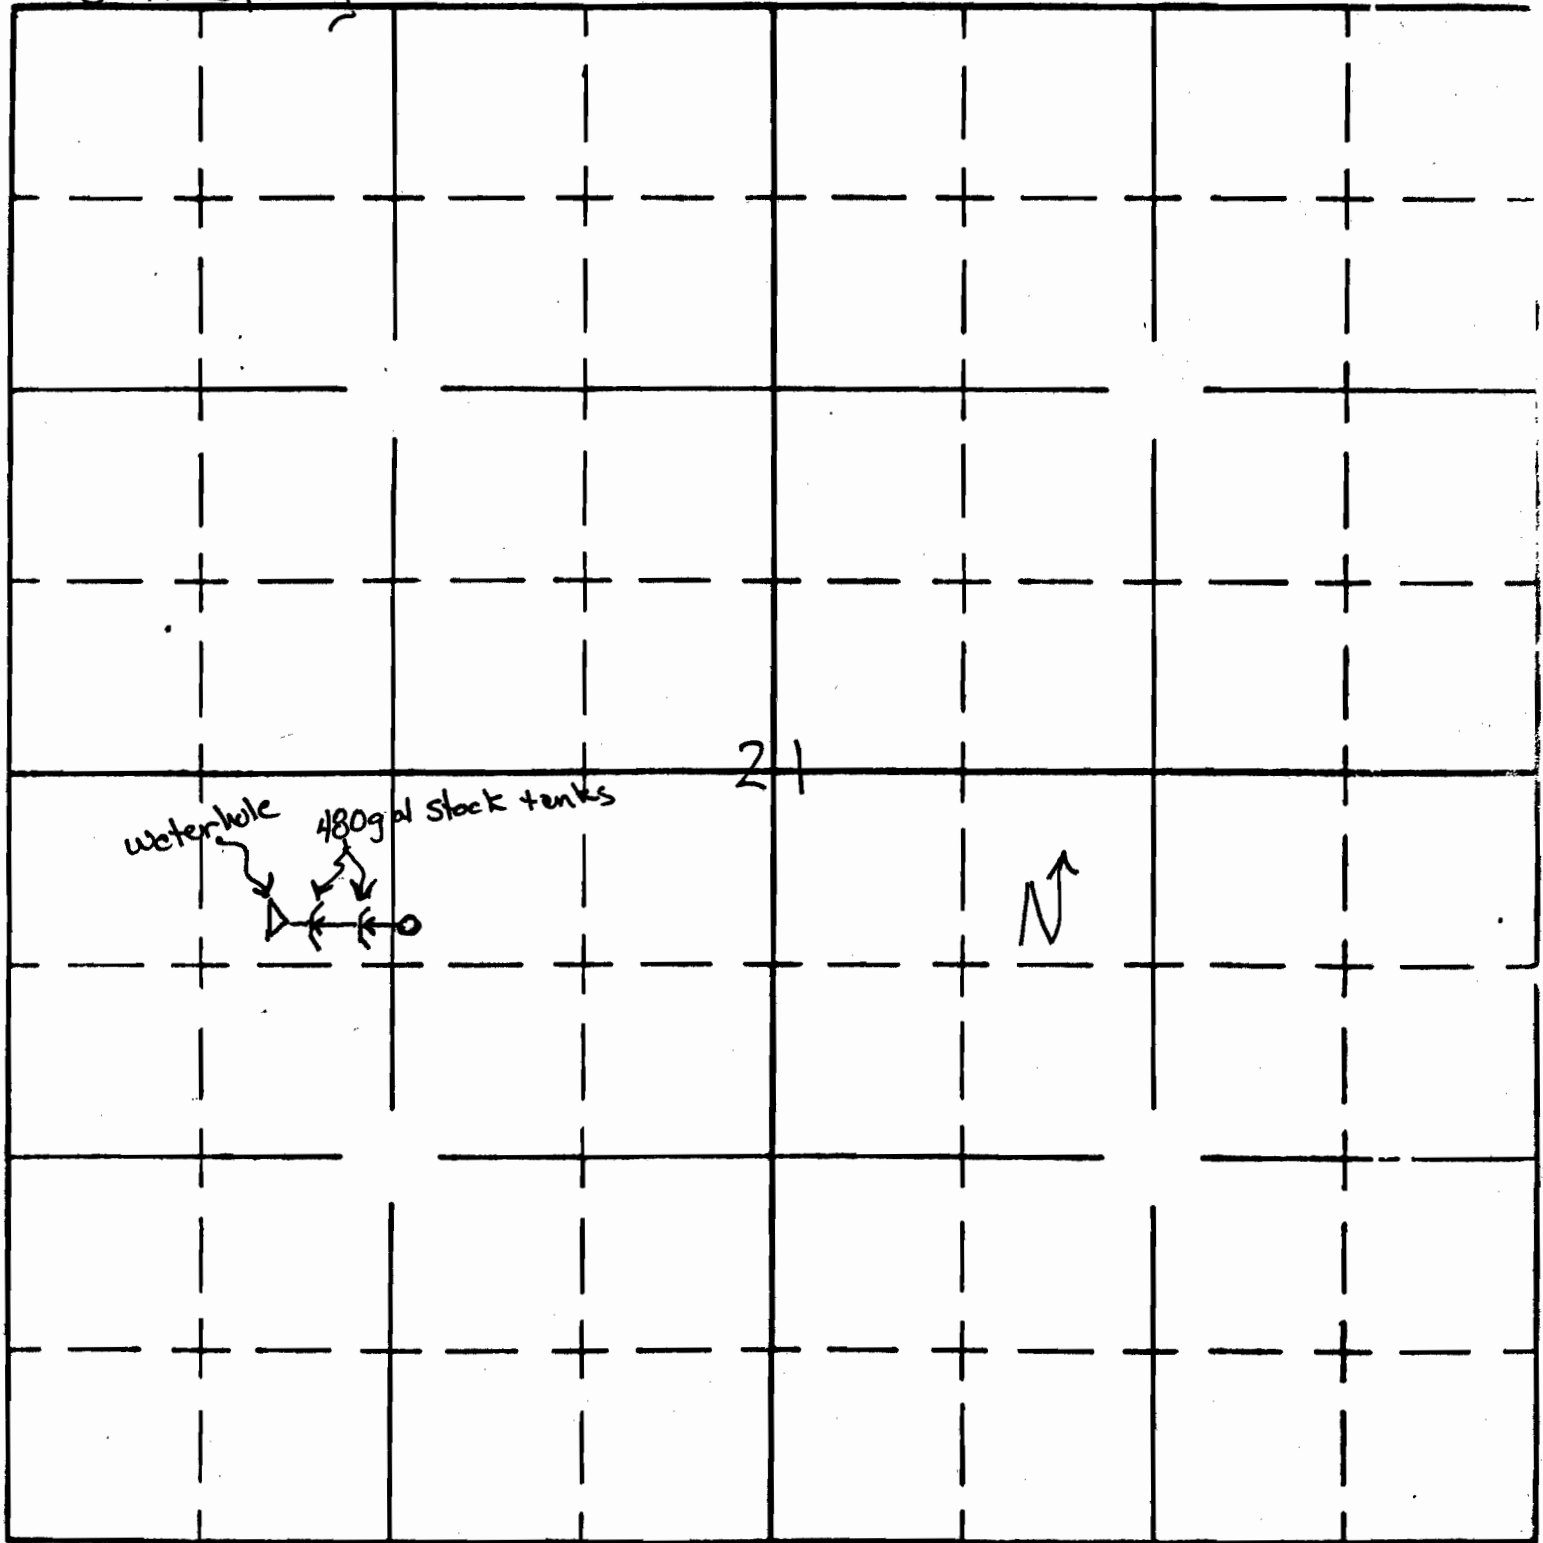

2150' N 1350' E of the SW corner of section 21

APPLICATION No. **67684**
48896