


SECTION

29
NE SW

09-0535
BOTTLE SEEP SPRING

TOWNSHIP 31S, RANGE 32³/₄E, W. M.

North

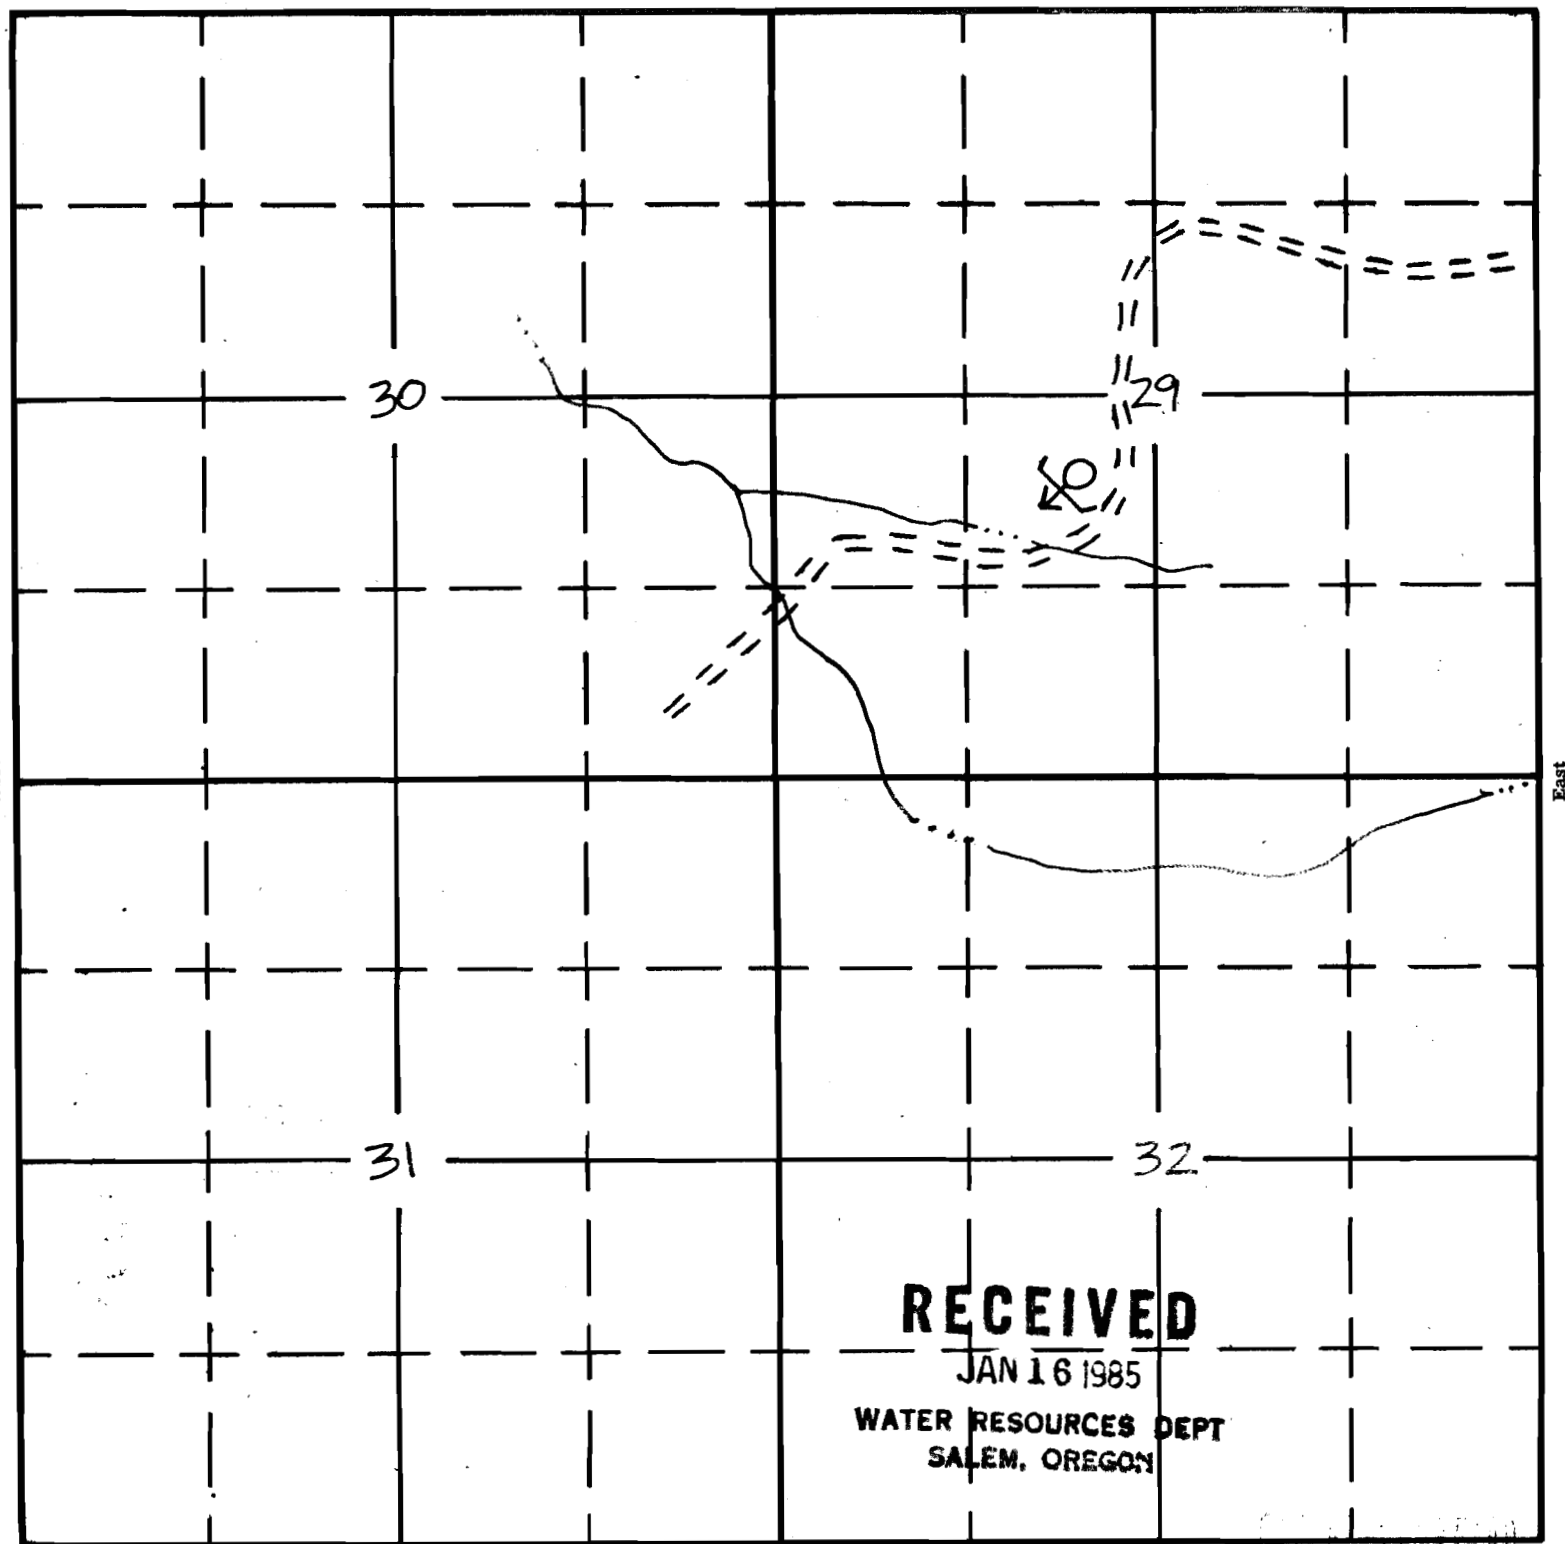

Application No. 68534
Permit No. 50G33

South

SL 11983
WATER RESOURCES DEPT.
SALEM, OREGON