


Bureau Of Land Mgt.
Borns District Ofc.
Beck Day Spring
5146

T. 38S., R. 34E., Sec 31, 2

Application No. 66574
Permit No. 50635


outlet
D.
Stack Tank
Jet Engine Container

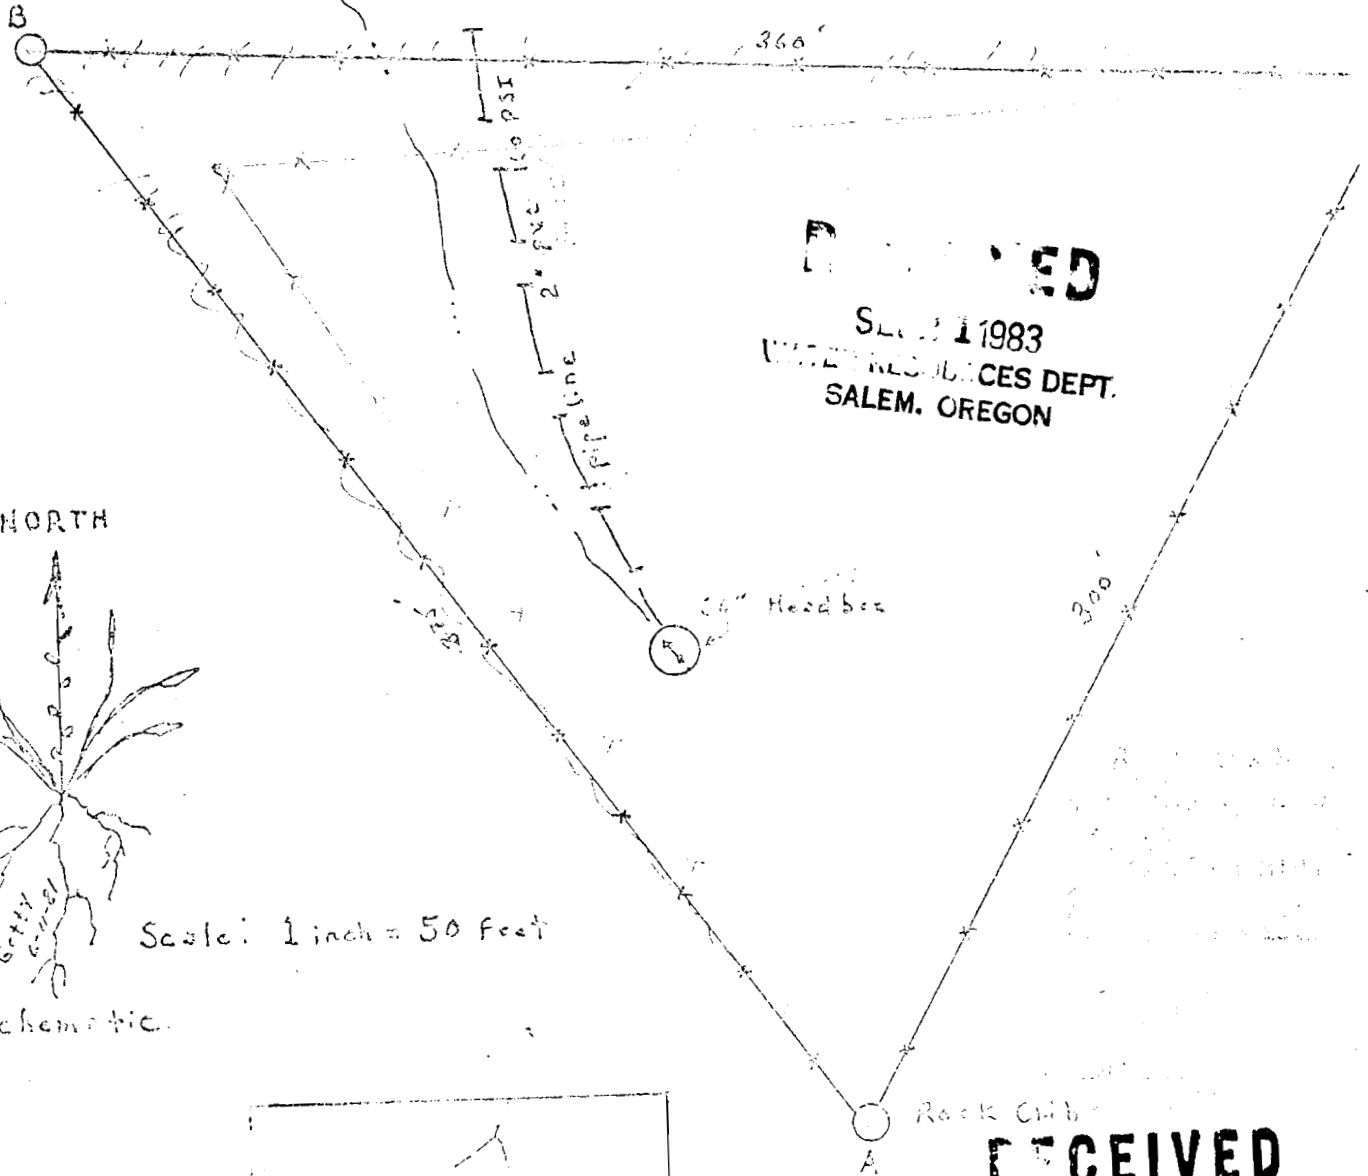

RECEIVED


SL 11983
WATER RESOURCES DEPT.
SALEM, OREGON

NORTH

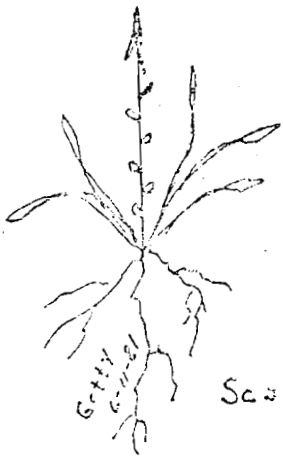

Scale: 1 inch = 50 Feet

DWG. Schematic.

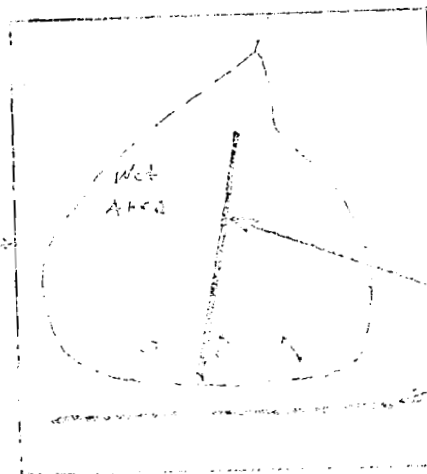

Spring Area Enlarged

Trench 10" to 24" for Sanitary Water

RECEIVED

JAN 16 1985

WATER RESOURCES DEPT.
SALEM, OREGON