


1. 265., R. 5W., W. 1M.

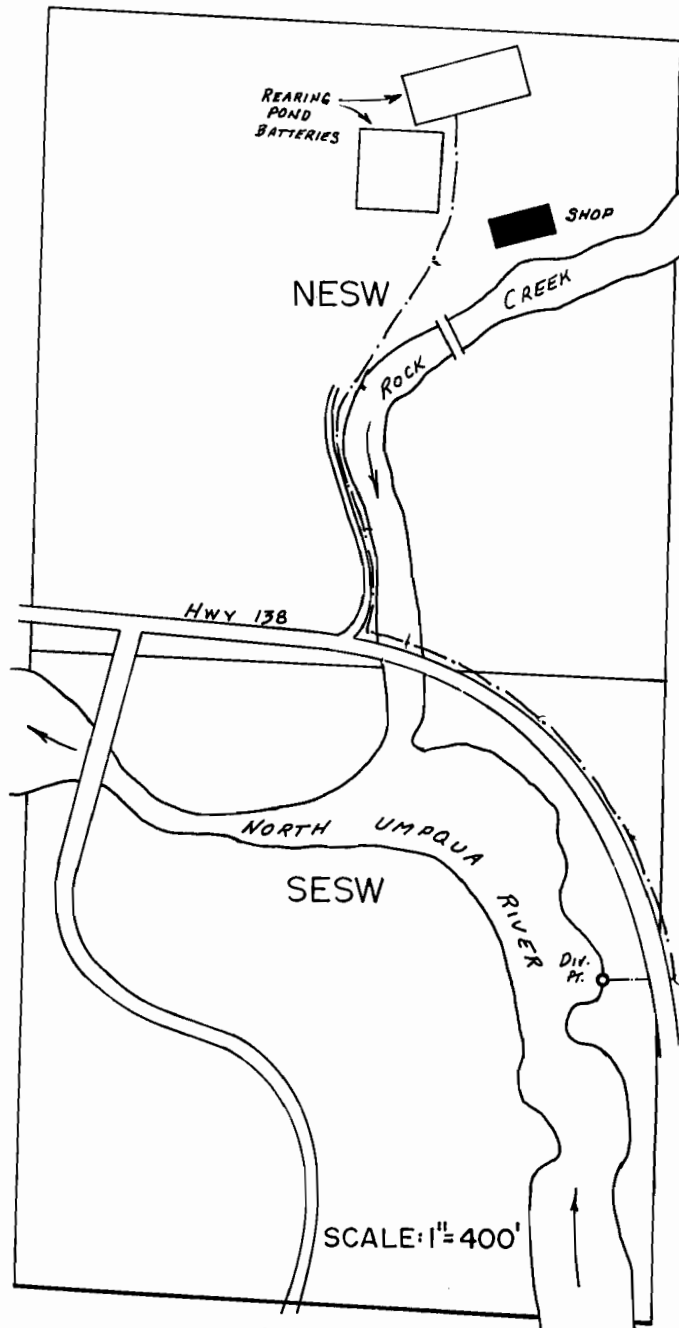

Div. Pt. Loc.: 1955 S. & 110' W. FROM C. 1/4 COR. SEC. 1. (A. # 54881)
 DIAMOND LAKE DIV. LOC.: 150' N. & 250' E. FROM SW COR.
 SEC. 30, T. 27S, R. 6 E., W. 1M. (A. # 57861)

FINAL PROOF SURVEY
 UNDER

57861 43627
 Application No. 54881... Permit No. 41447.....
 IN NAME OF

OREGON DEPARTMENT OF FISH & WILDLIFE

Surveyed JAN. 22. 19.80., by J.S. DONALDSON