STATE ENGINEER
RECEIVED

SEP 12 1923

SALEM, OREGON

MAP

Accompanying application of Ed Metcalf to appropriate water in Sec 2, Twp 26 S. R. 14 W.W.M.
Scale 2 inches = 1 mile

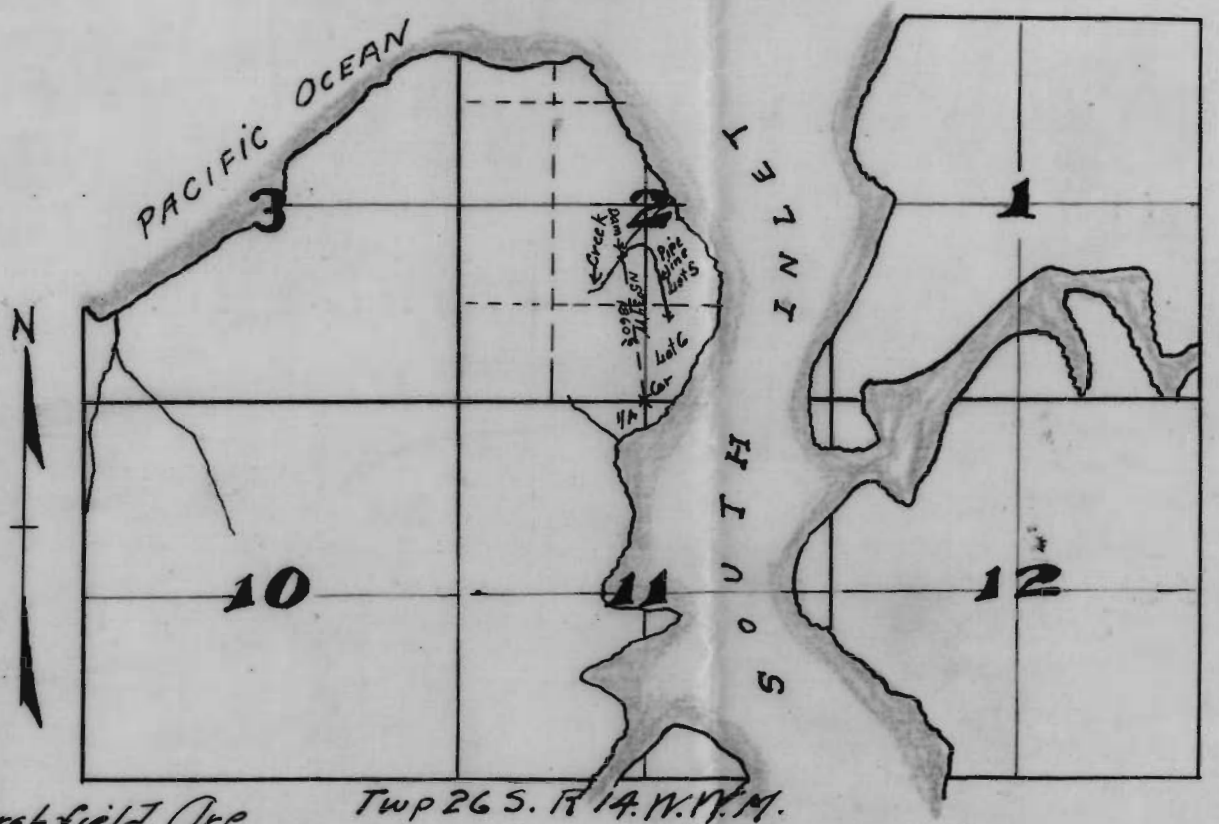

Twp 26 S. R 14. W.W.M.

REGISTERED PROFESSIONAL ENGINEER 112 D. L. BUCKINGHAM OREGON DEC. 8, 1919

D. L. Buckingham

I. D.L. Buckingham, of Marshfield Ore do hereby certify that this map was made from notes taken during an actual Survey made by me Aug 21 1923, and that it correctly represents the works described in the accompanying application together with the location of all streams and pipe lines in the immidate Vicinity

D. L. Buckingham

Application No. 9171
Permit No. 7606