


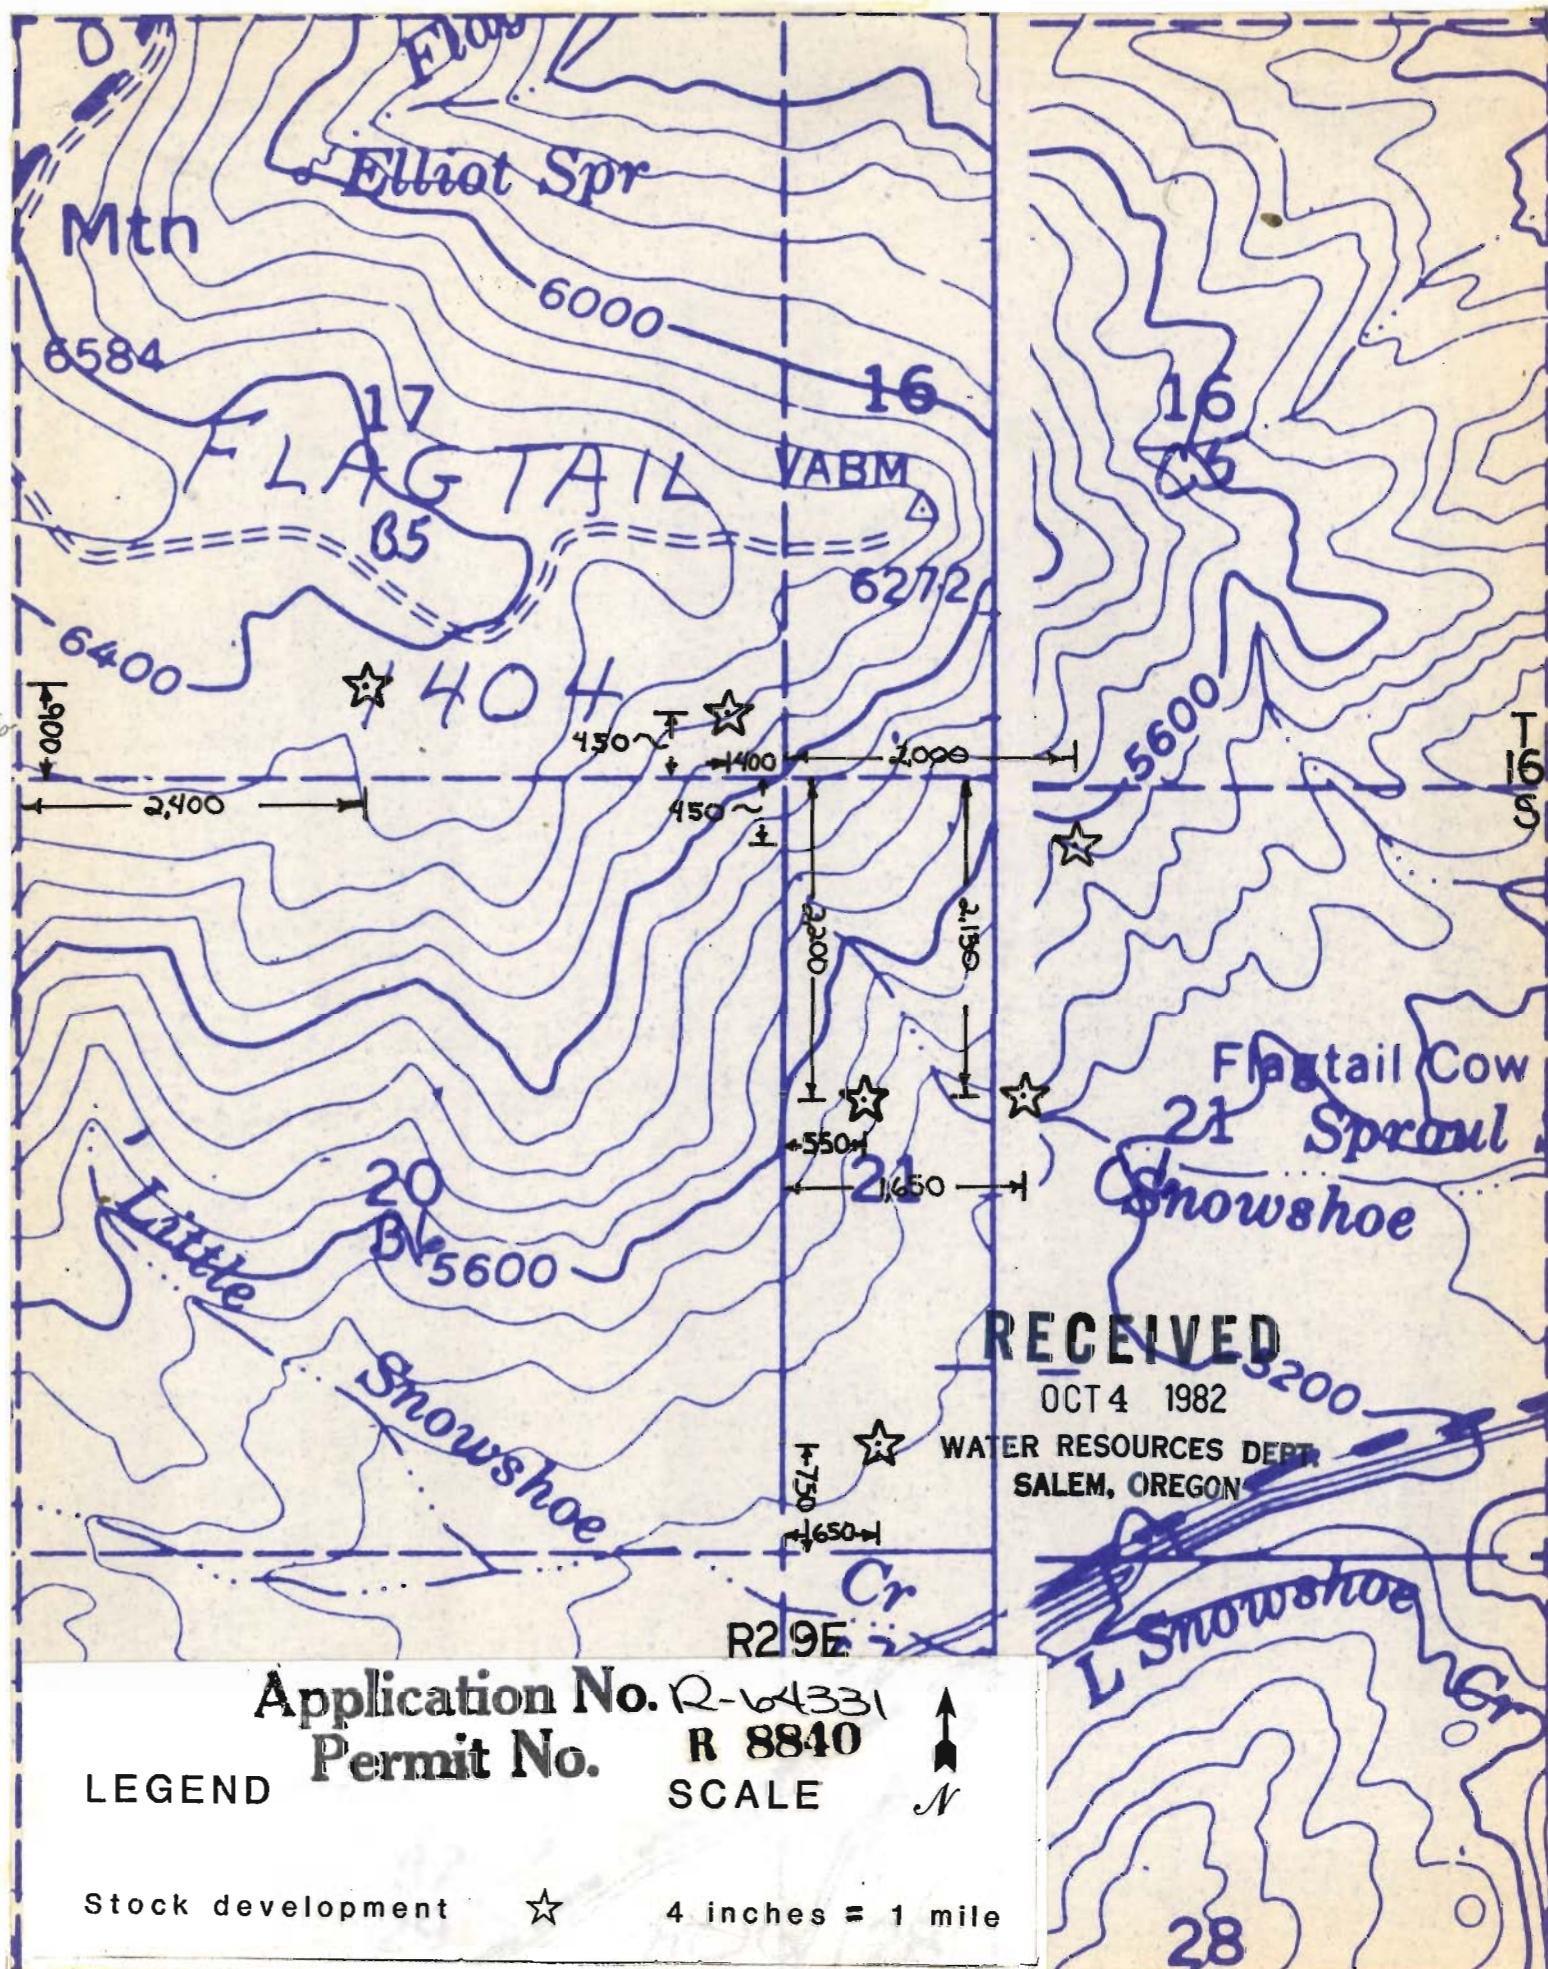

RECEIVED

OCT 4 1982

WATER RESOURCES DEPT
SALEM, OREGON

Application No. R-64331

Permit No. R 8840

LEGEND

SCALE



Stock development



4 inches = 1 mile