


Application No. R-64333
Permit No. R 8842

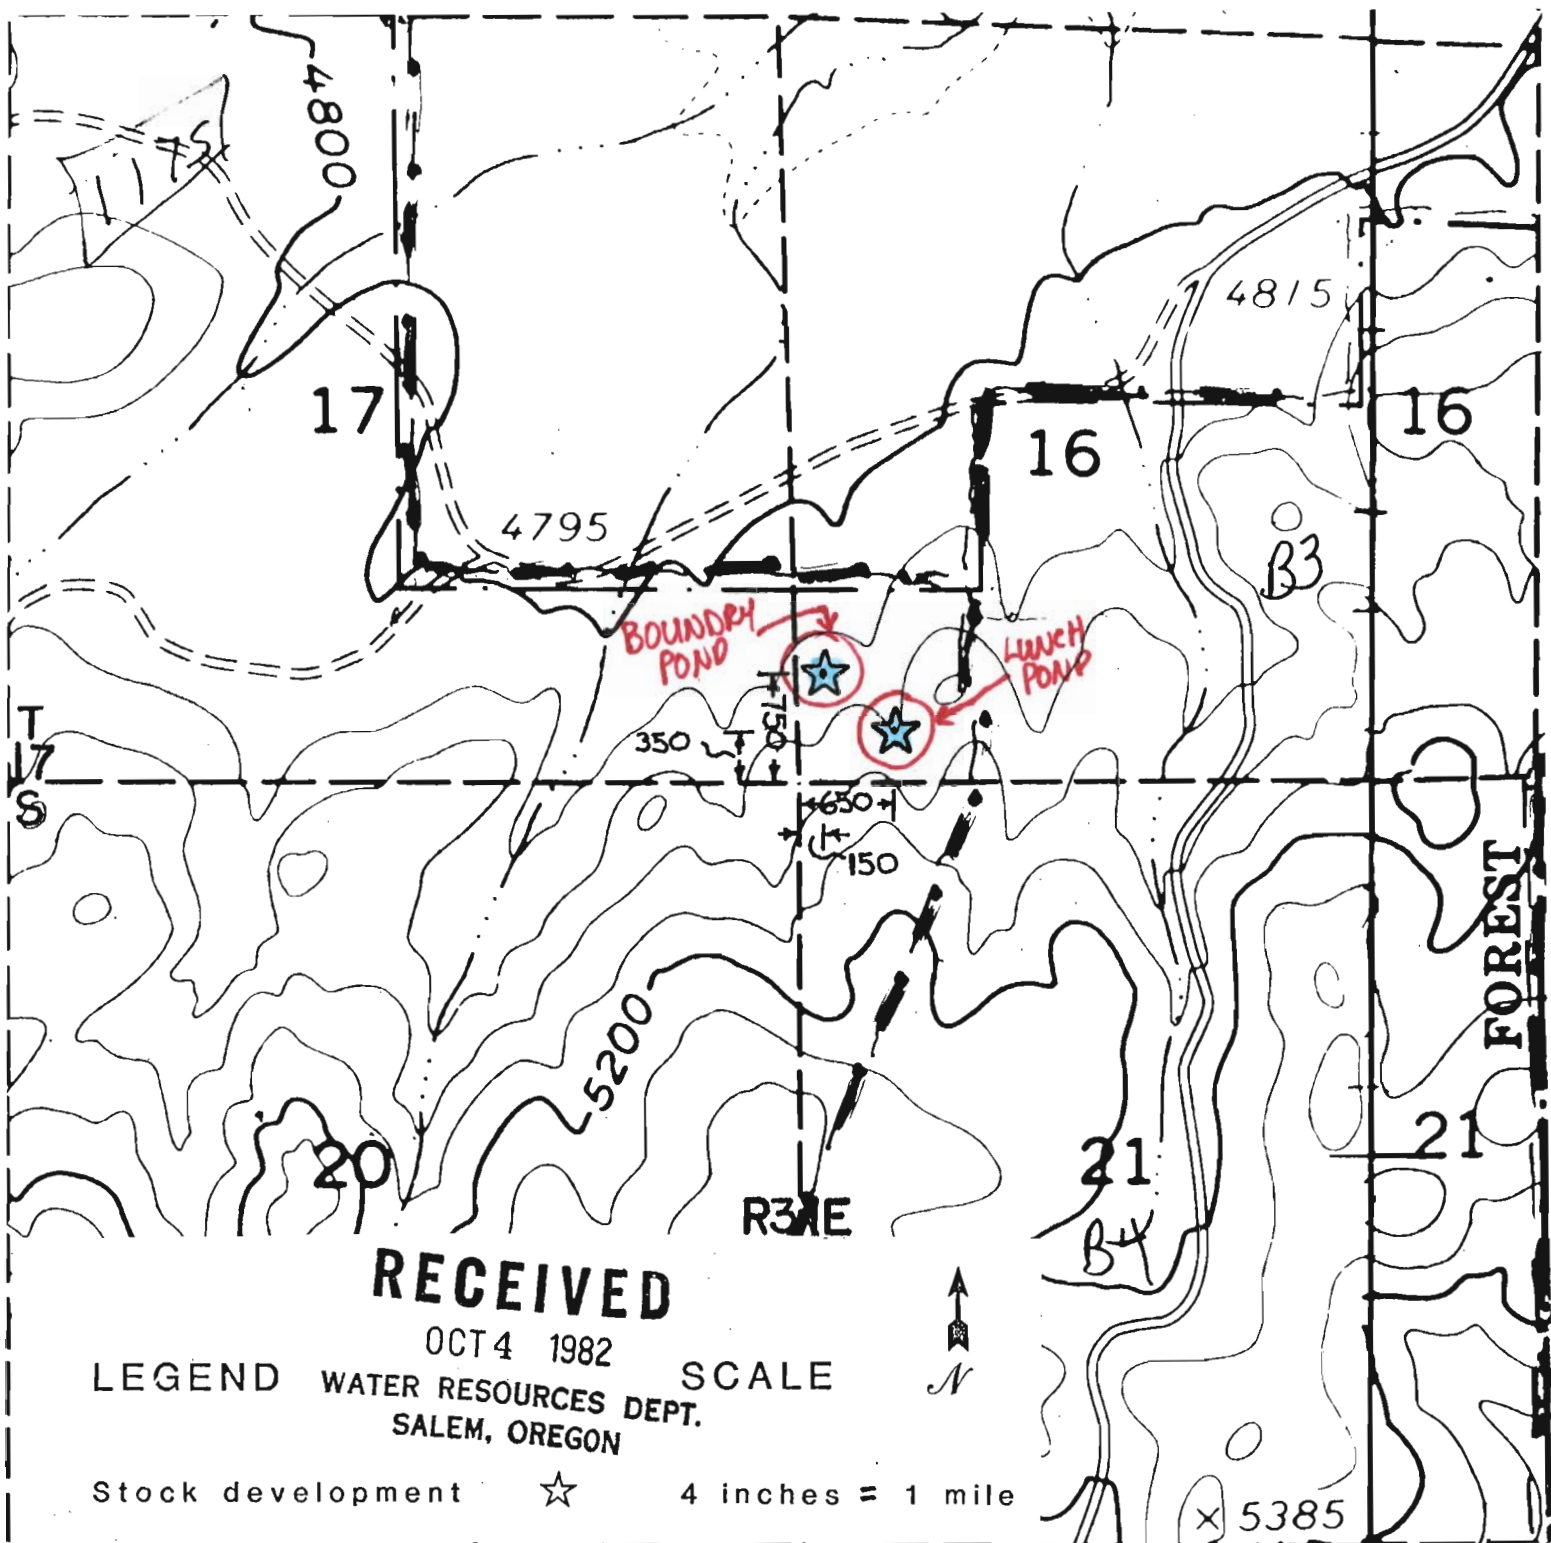

RECEIVED

OCT 4 1982

LEGEND WATER RESOURCES DEPT.
SALEM, OREGON

SCALE

Stock development ☆ 4 inches = 1 mile

x 5385