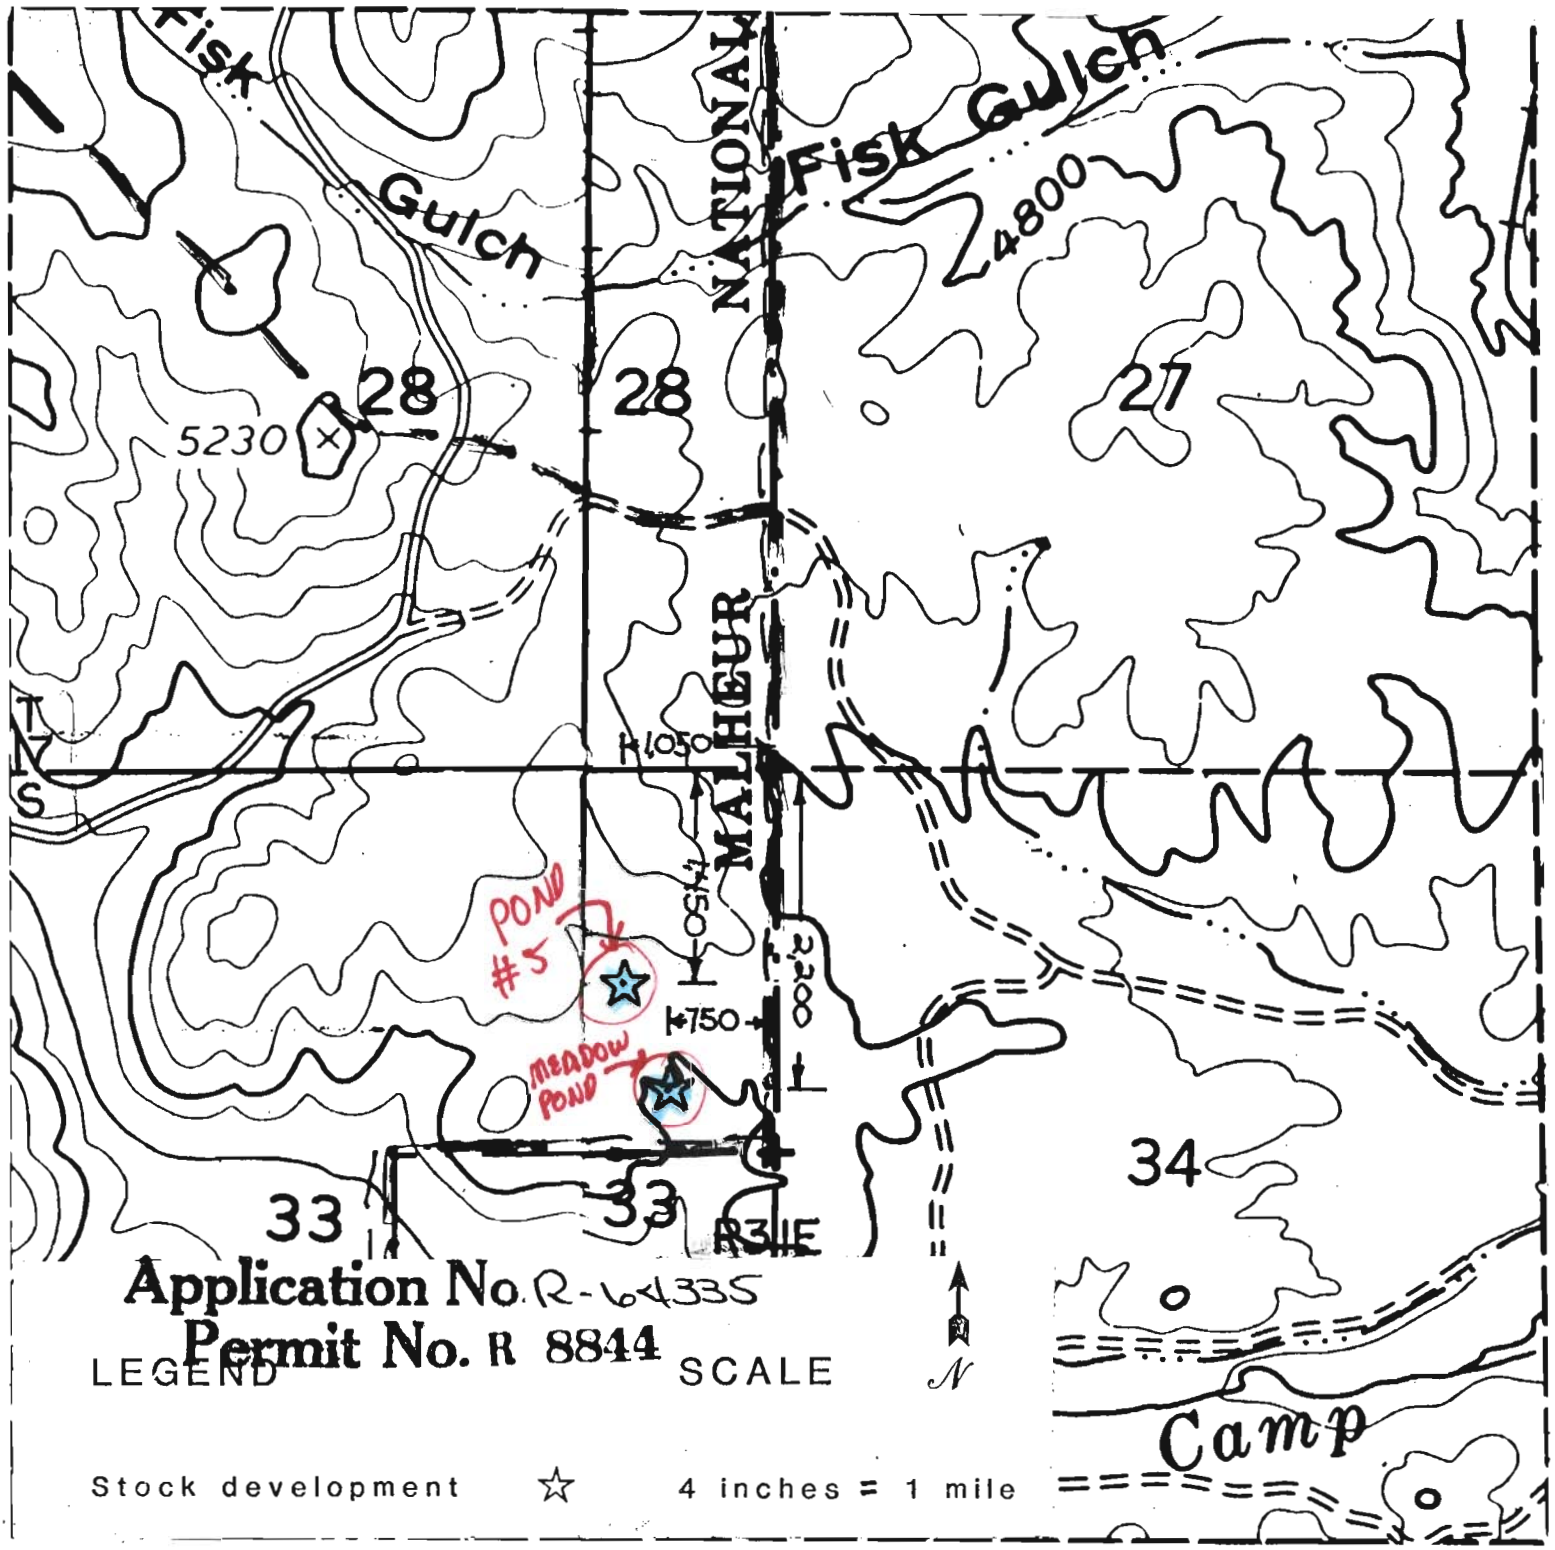

Application No. R-64335
Permit No. R 8844

RECEIVED
OCT 4 1982
WATER RESOURCES DEPT.
SALEM, OREGON