


RECEIVED
OCT 4 1982
WATER RESOURCES DEPT.
SALEM, OREGON

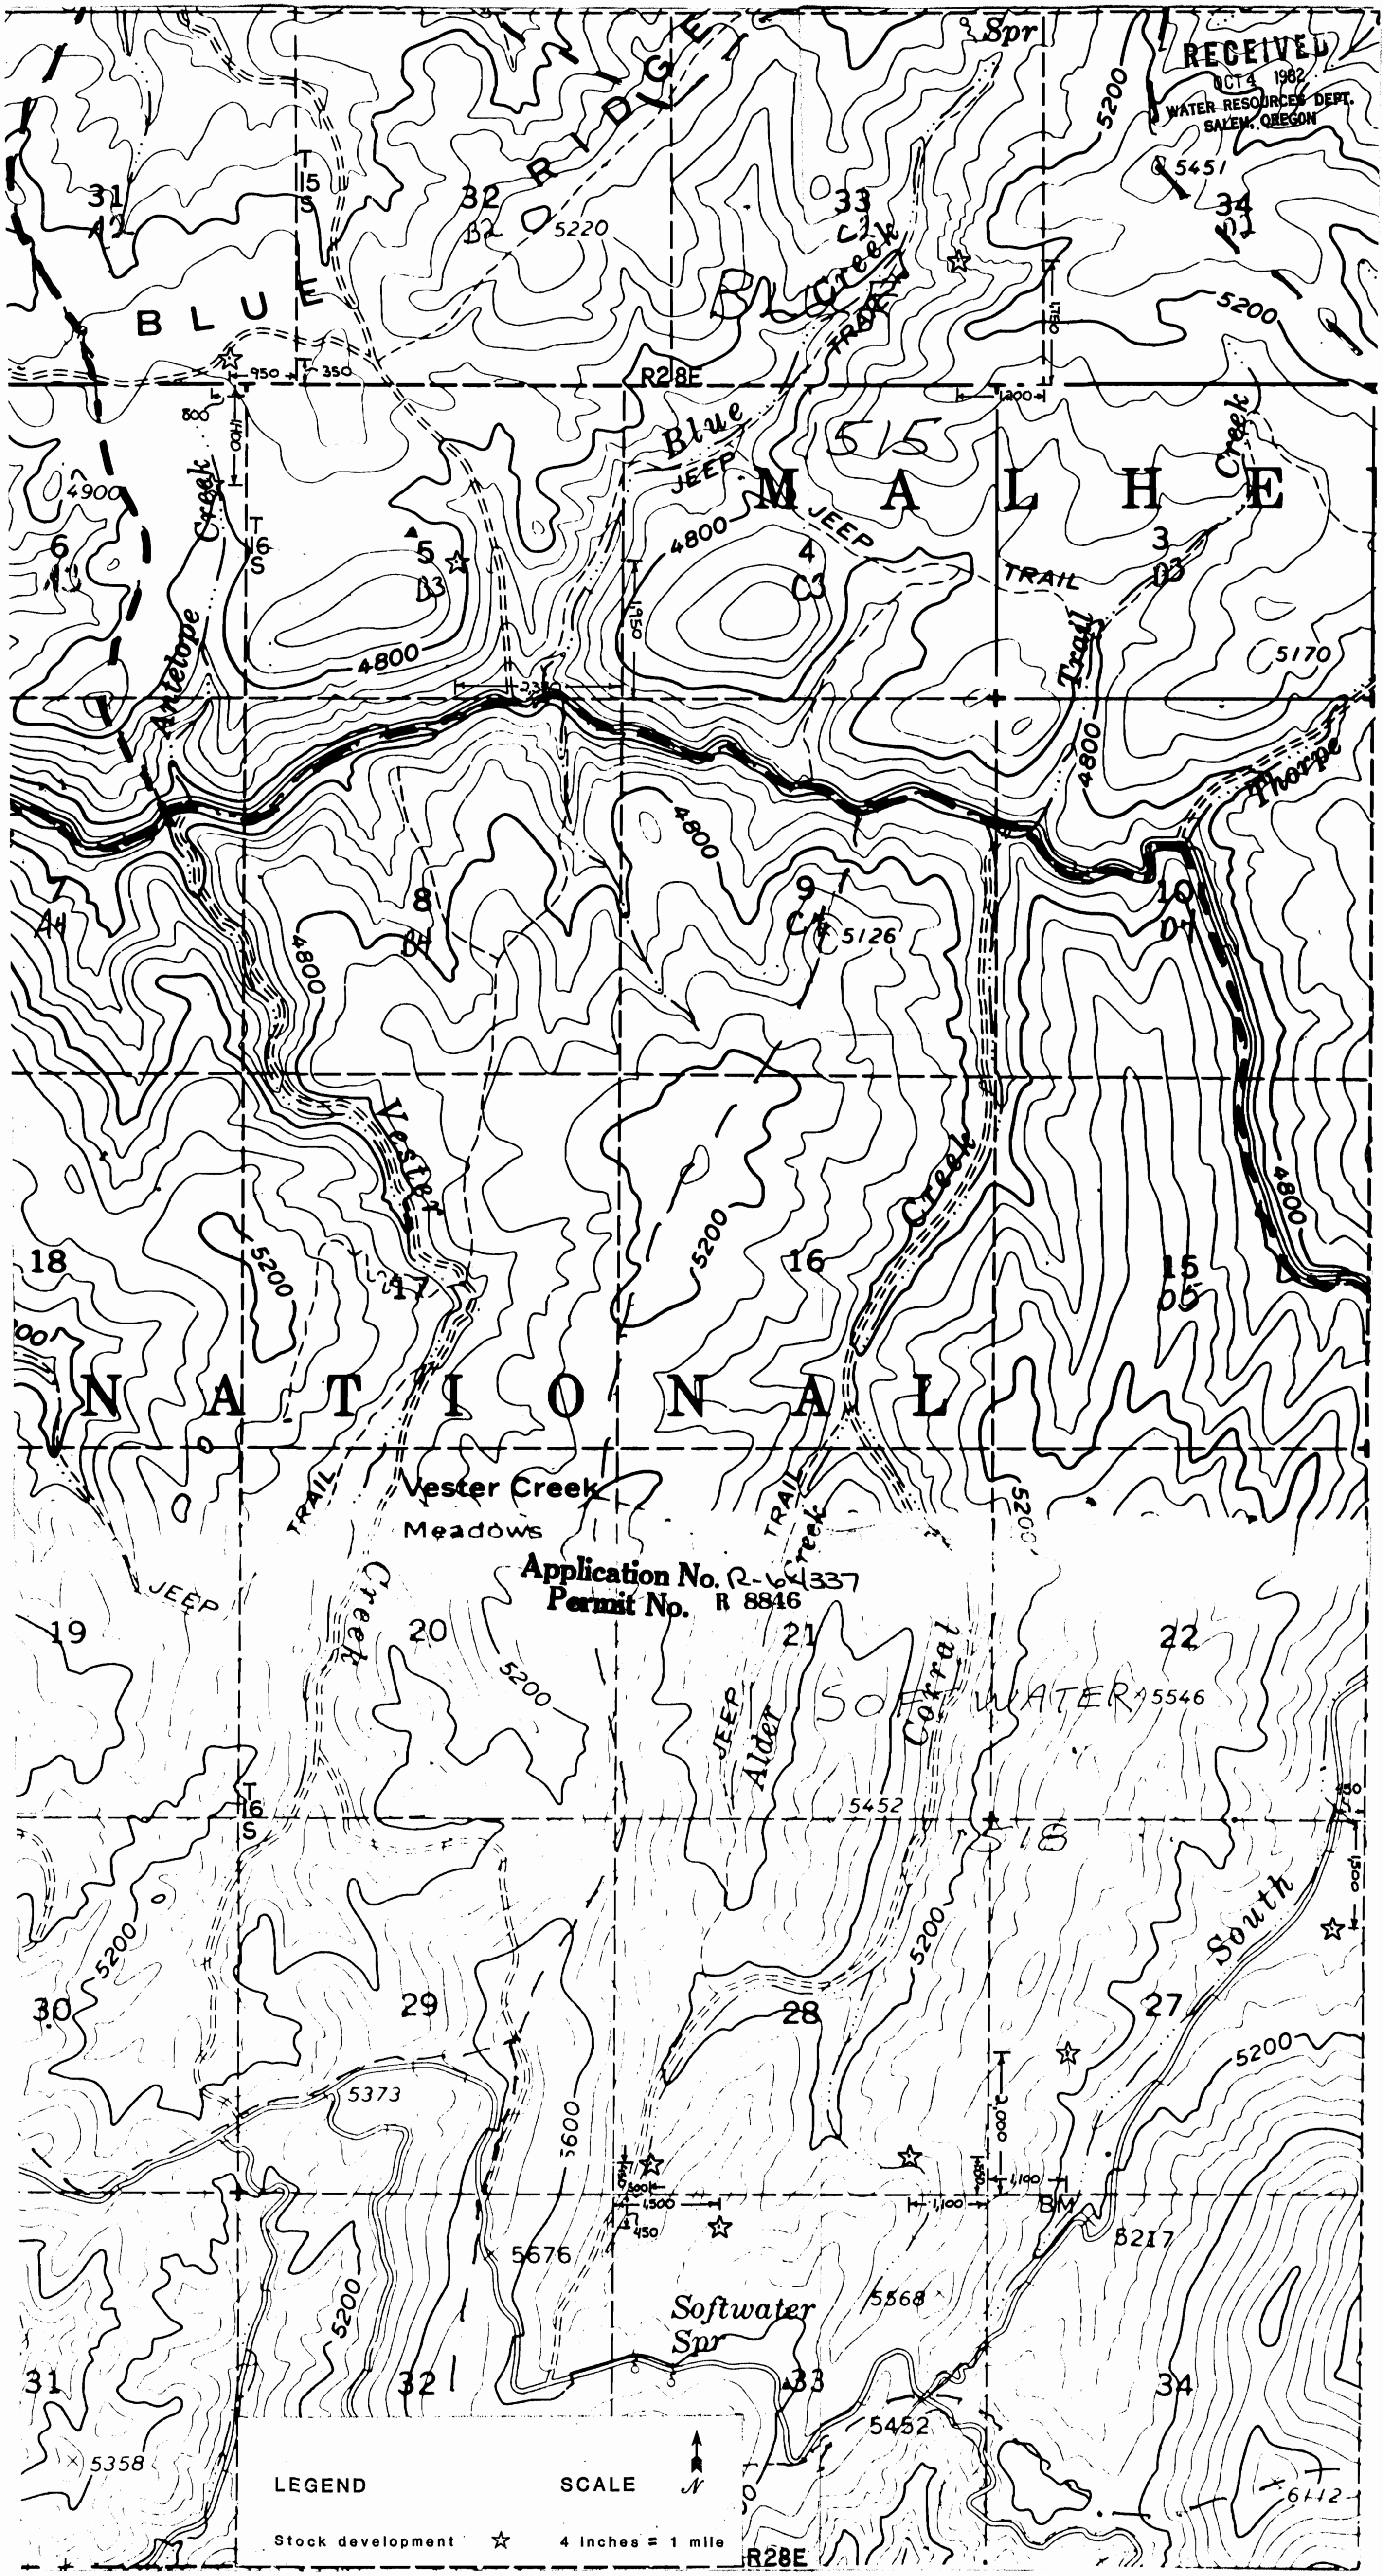

Application No. R-64337
Permit No. R 8846

LEGEND
Stock development ☆
SCALE
4 inches = 1 mile

R28E