


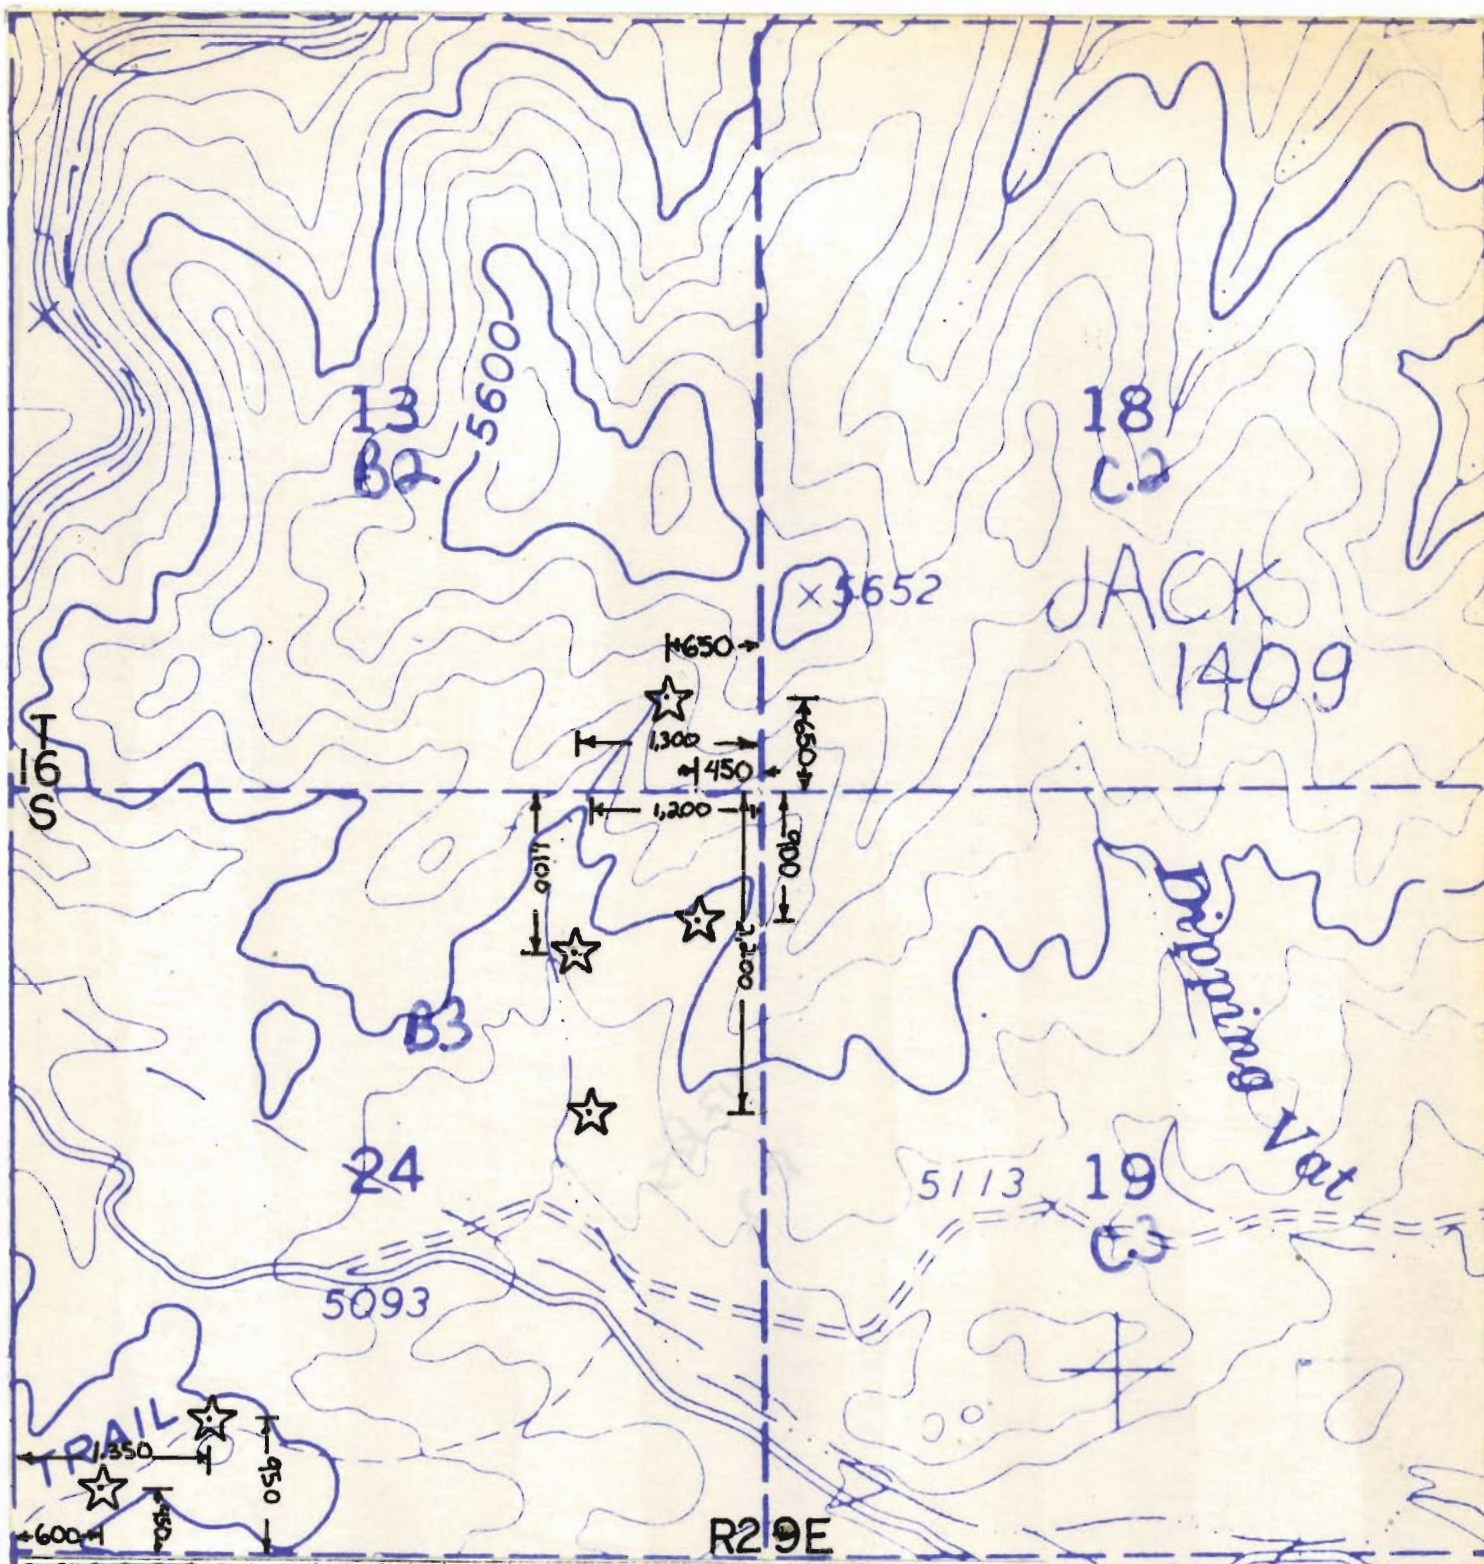

Application No. R-64338
 Permit No. R 8847

LEGEND

SCALE



Stock development



4 inches = 1 mile

RECEIVED

OCT 4 1982

WATER RESOURCES DEPT.
 SALEM, OREGON