


Application No. R-61340
Permit No. R 8849

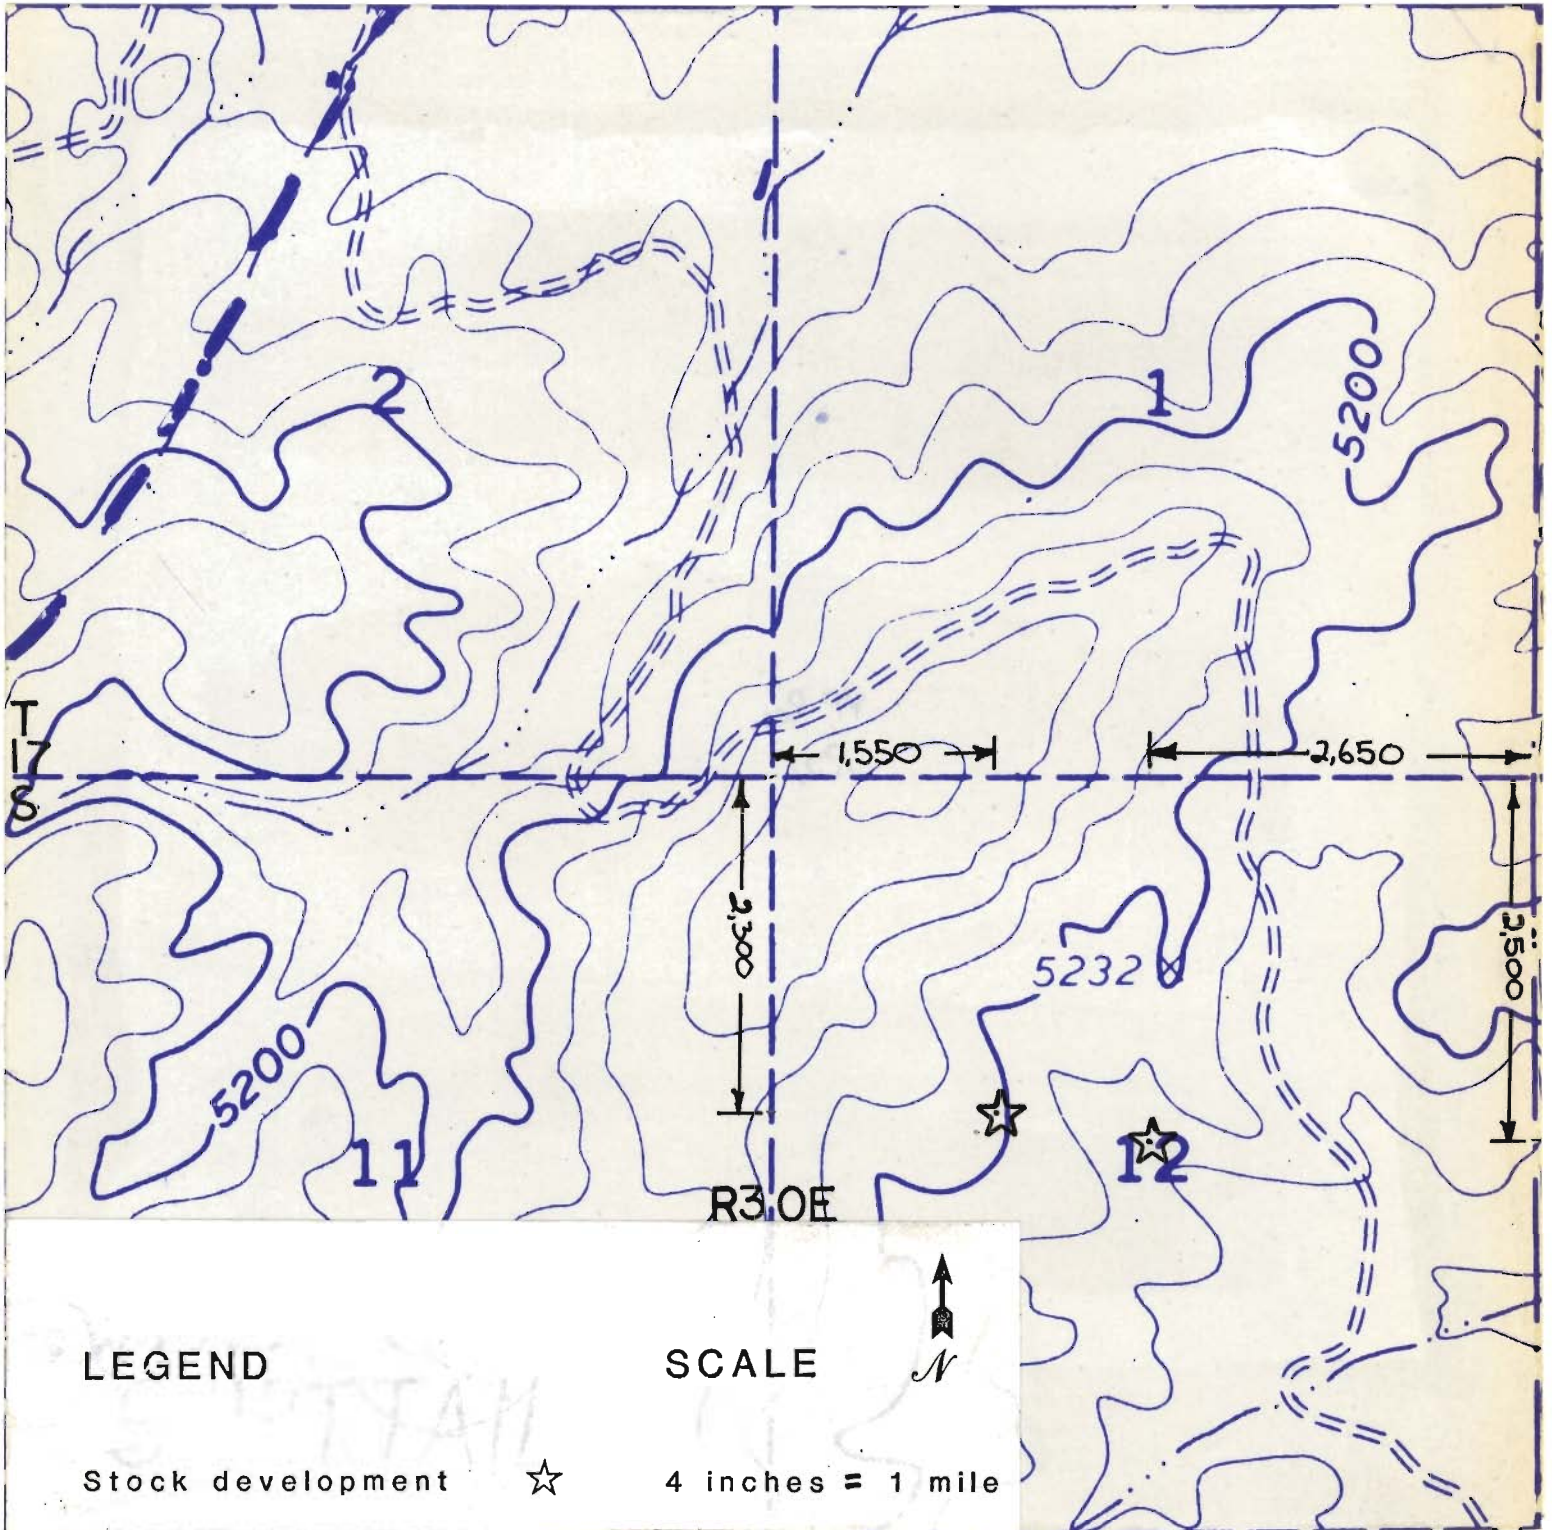

RECEIVED
OCT 4 1982
WATER RESOURCES DEPT.
SALEM, OREGON