


Application No. R-64341
Permit No. R 8853

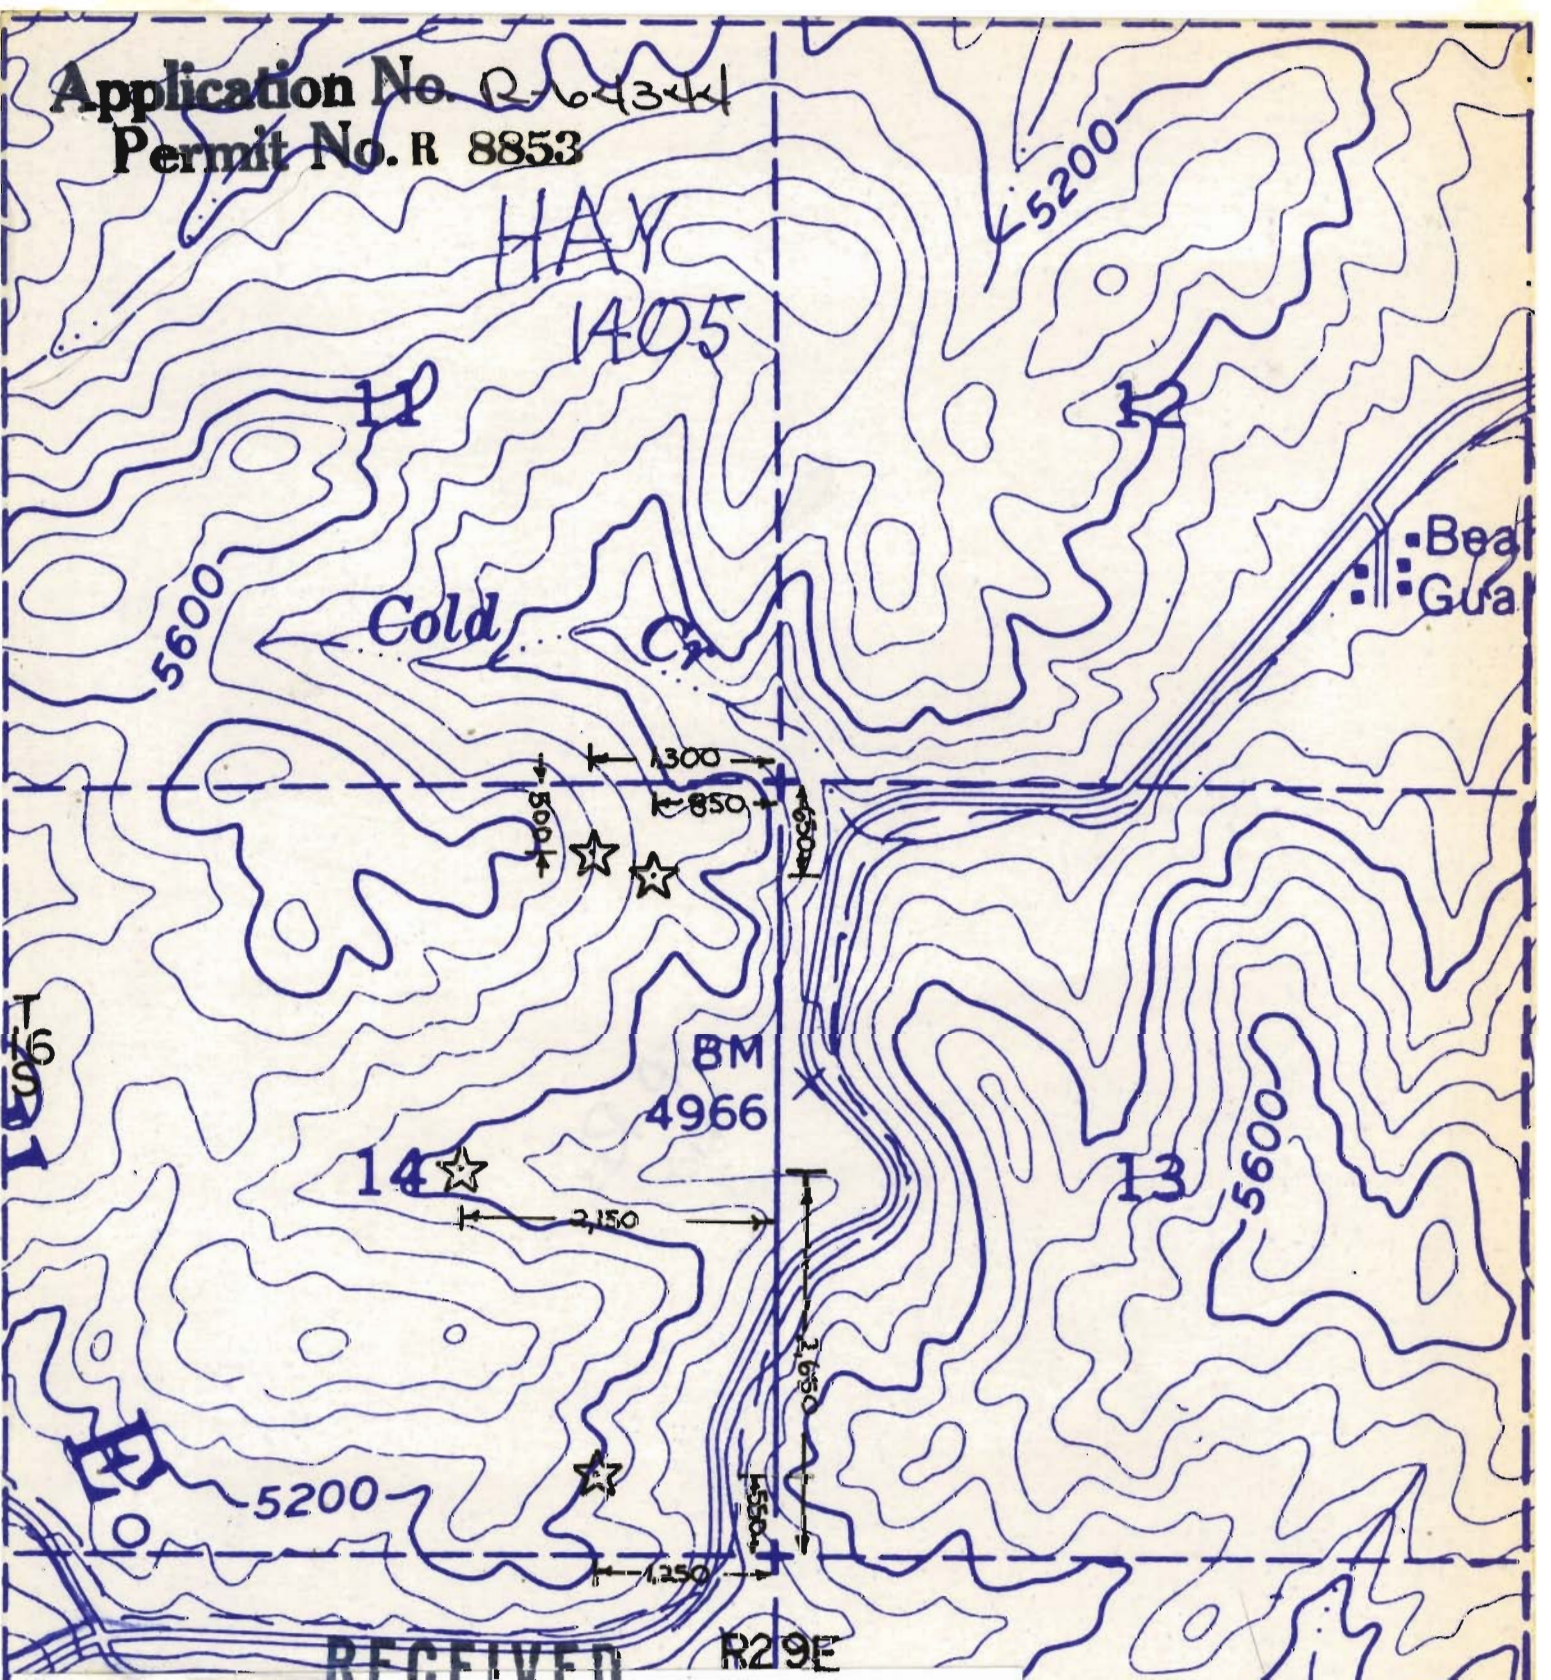

RECEIVED

OCT 4 1982

LEGEND WATER RESOURCES DEPT SCALE
SALEM, OREGON



Stock development ☆ 4 inches = 1 mile

24