


Application No. R-64345
Permit No. R 8854

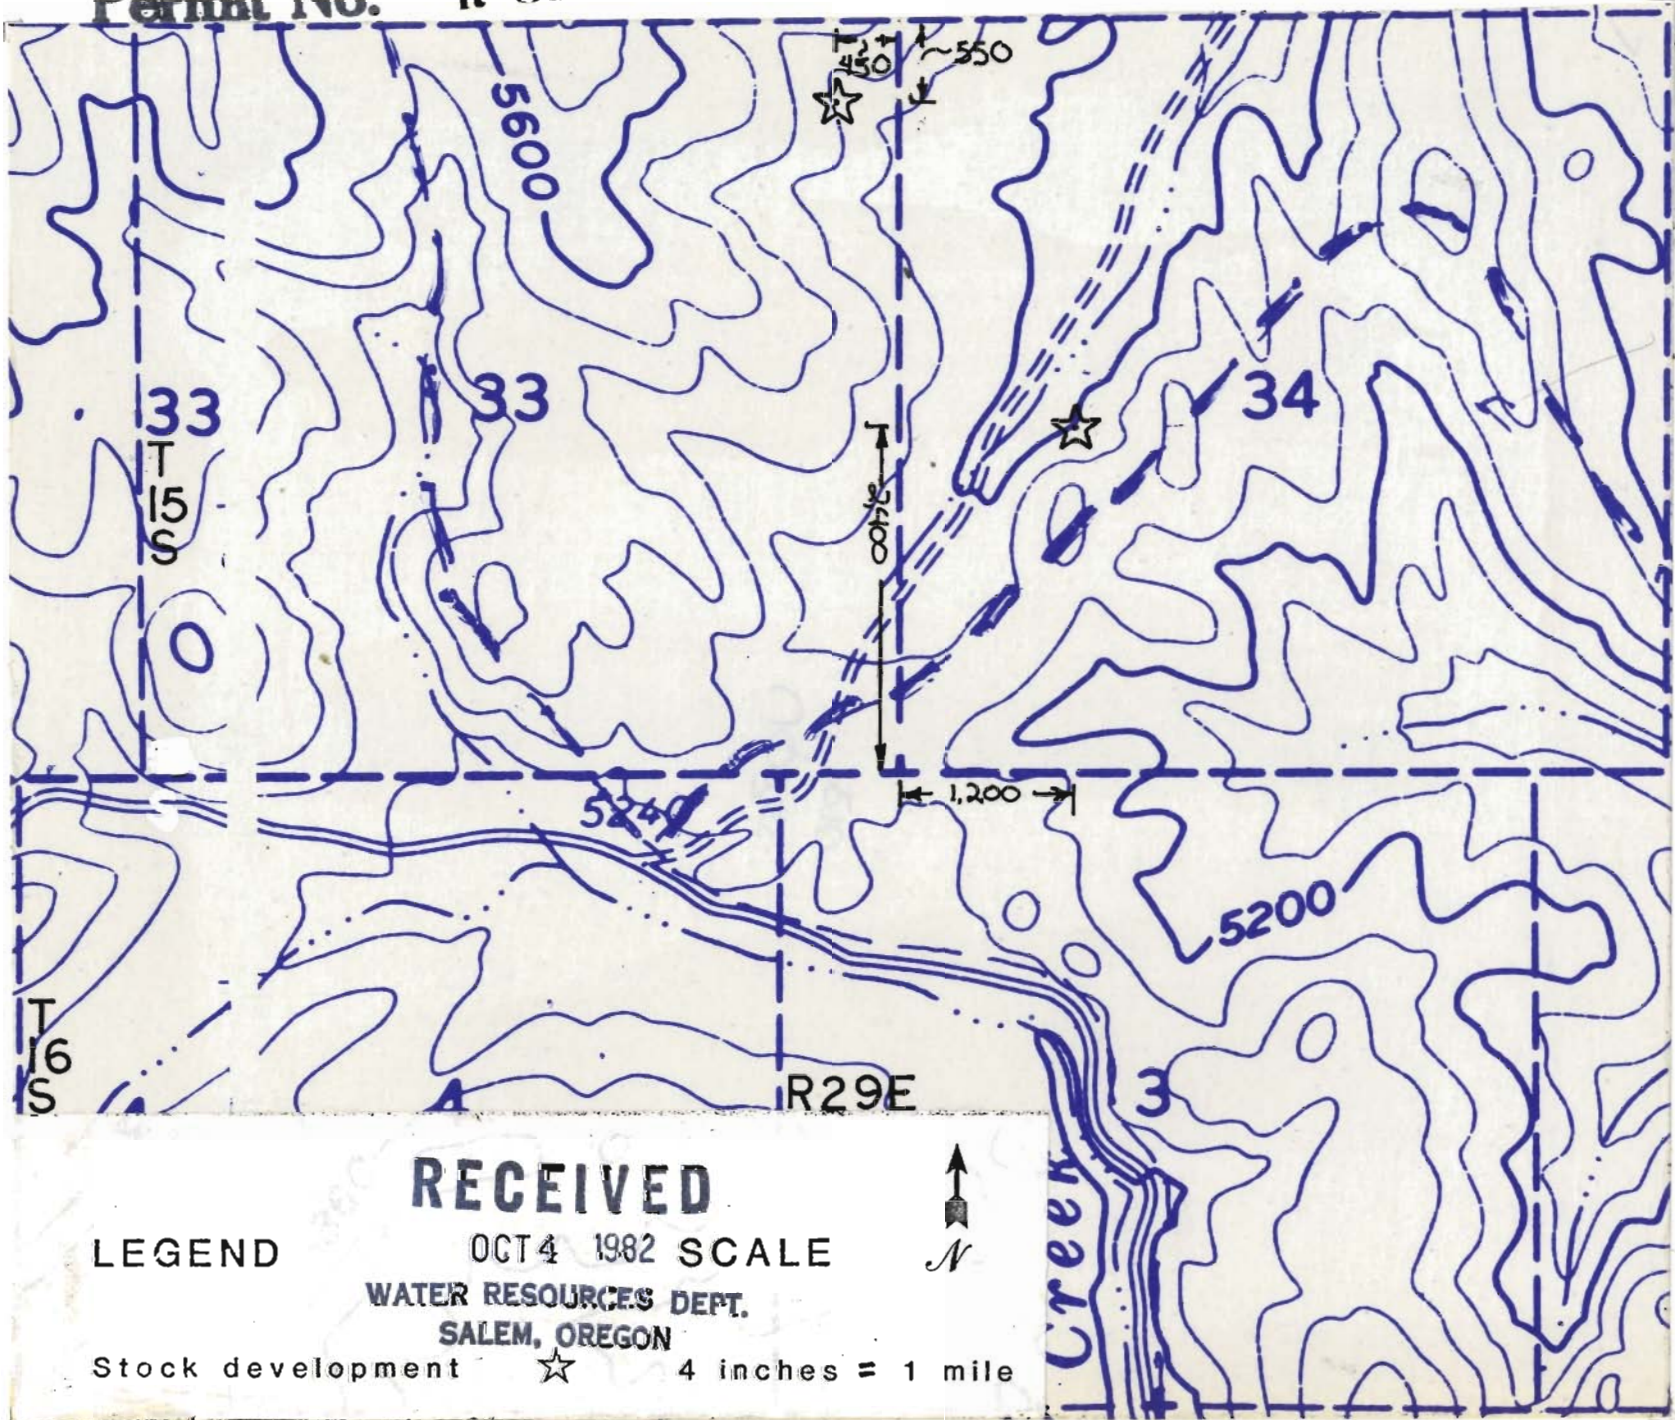

RECEIVED

LEGEND

OCT 4 1982 SCALE

WATER RESOURCES DEPT.
SALEM, OREGON

Stock development



4 inches = 1 mile

