


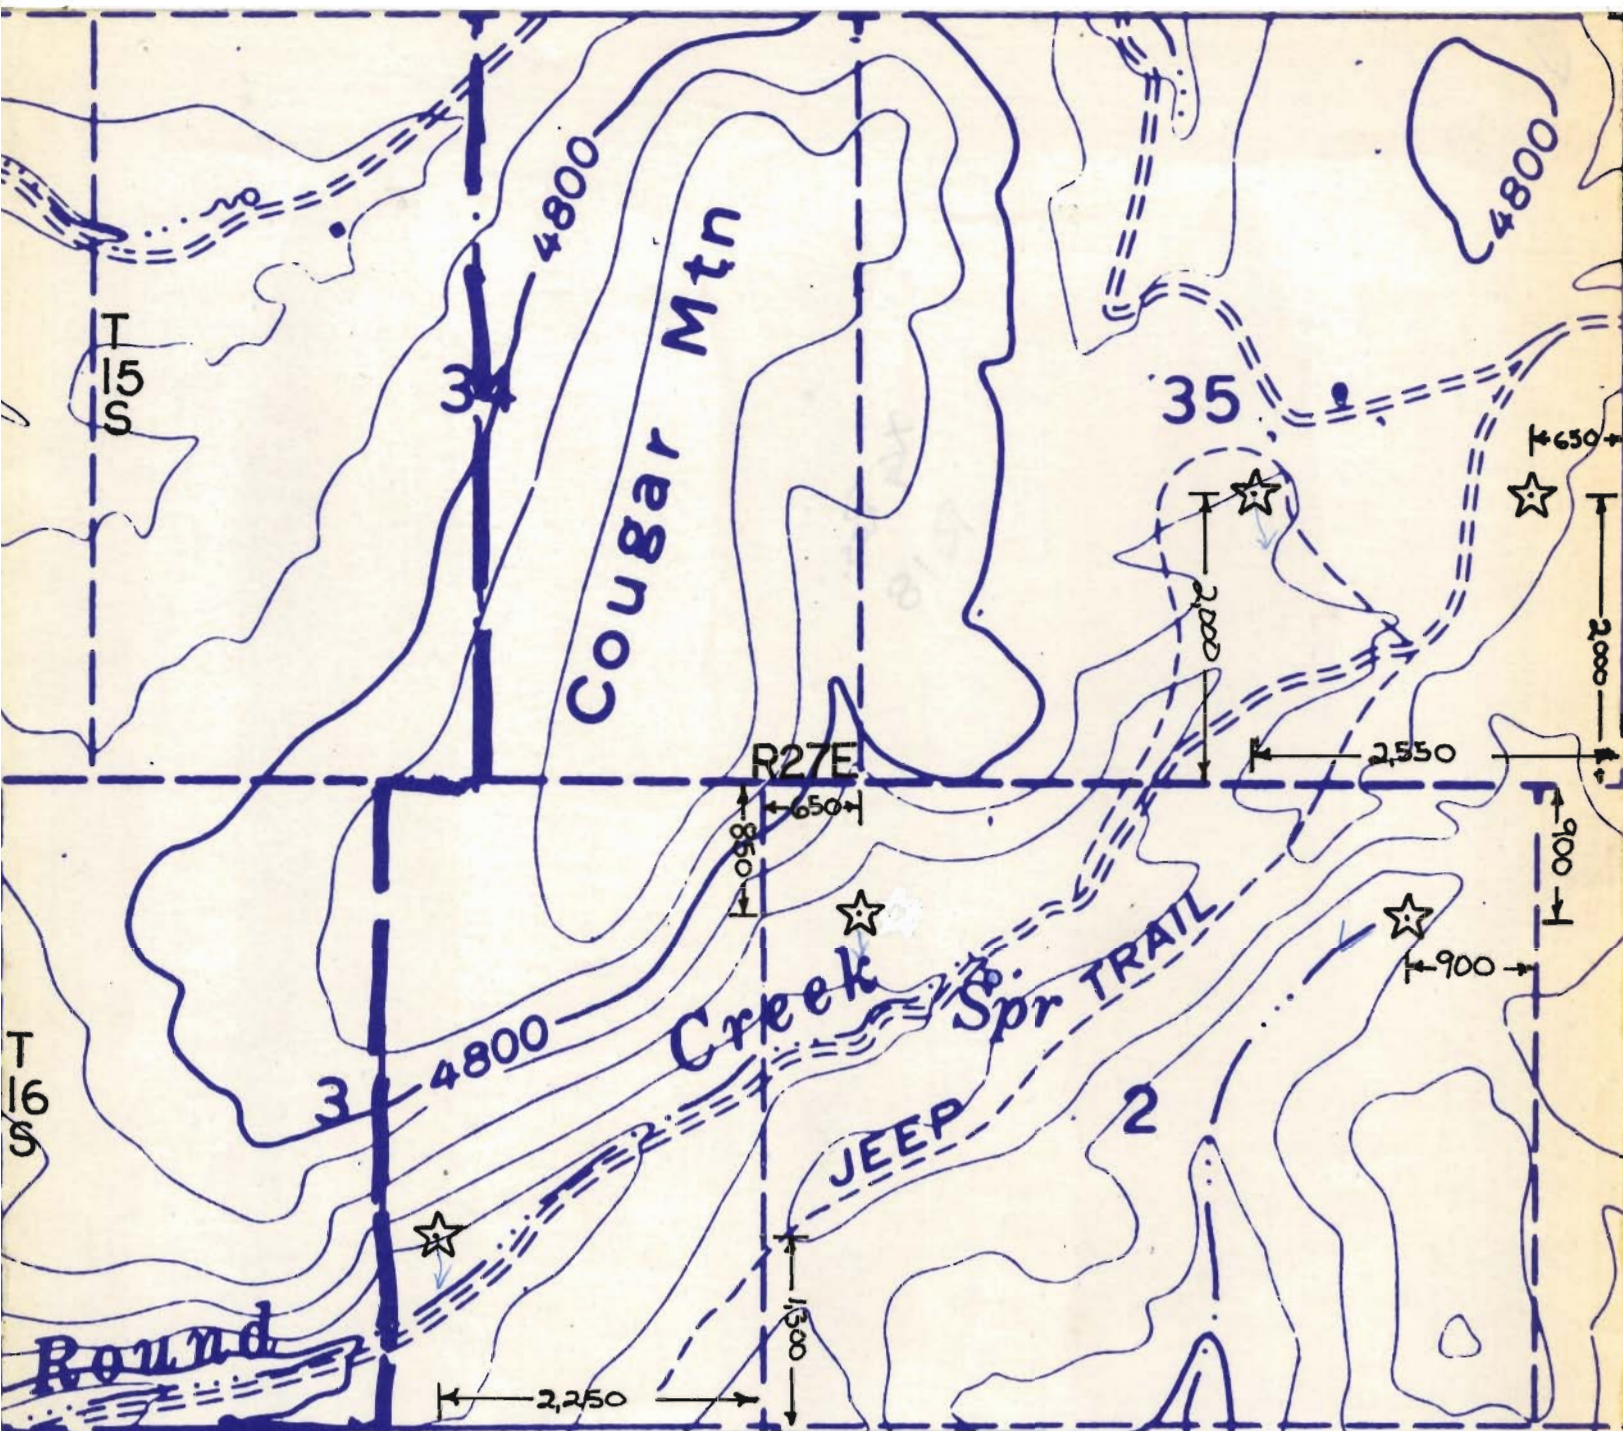

Application No R-64346

Permit No. R 8855

LEGEND

SCALE



Stock development



4 inches = 1 mile

RECEIVED

OCT 4 1982
WATER RESOURCES DEPT.
SALEM, OREGON