


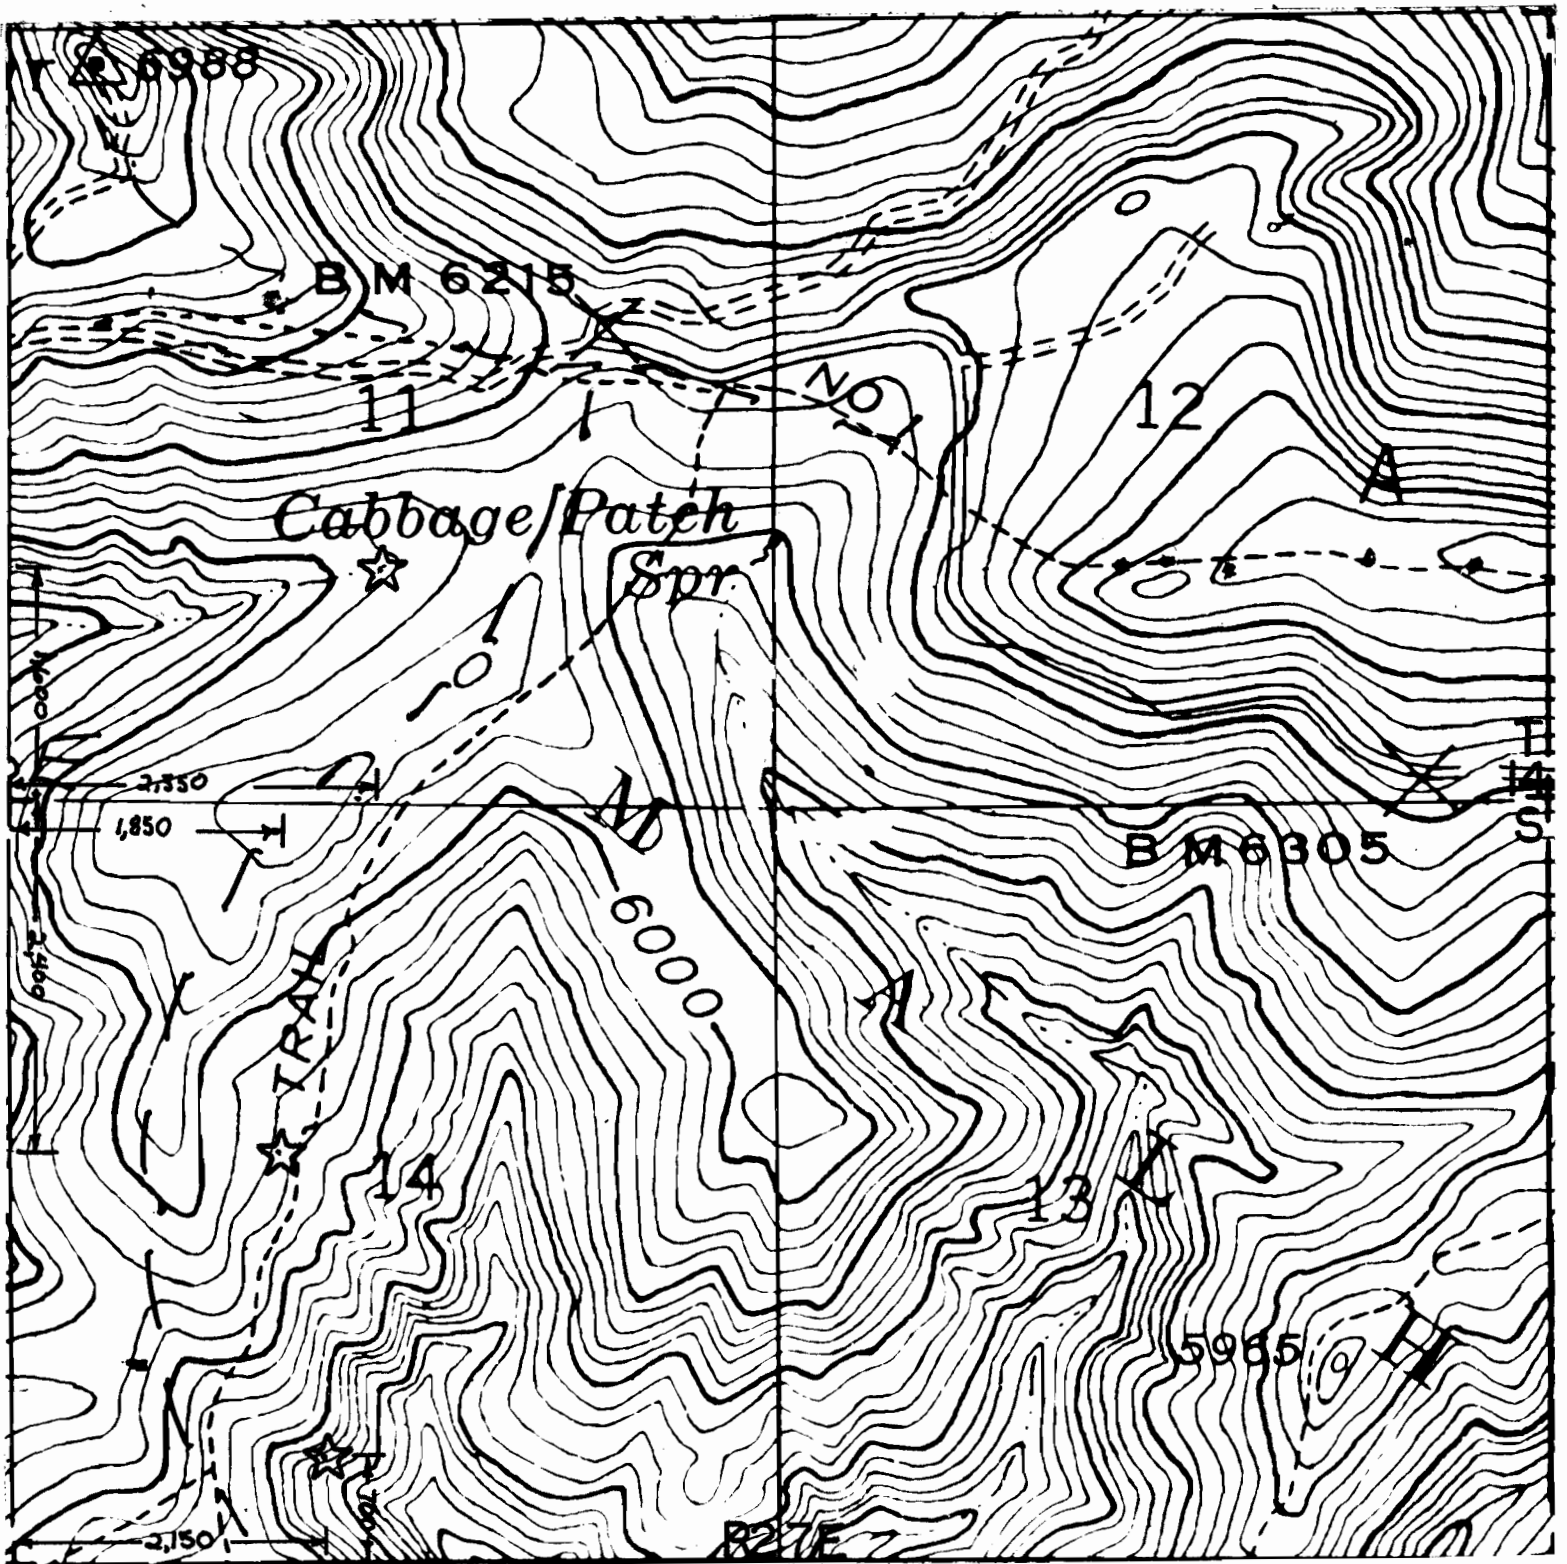

Application No. R-64350

Permit No. R 8859

LEGEND

SCALE



RECEIVED

OCT 4 1982

WATER RESOURCES DEPT.
SALEM, OREGON

Stock development ☆

4 inches = 1 mile