


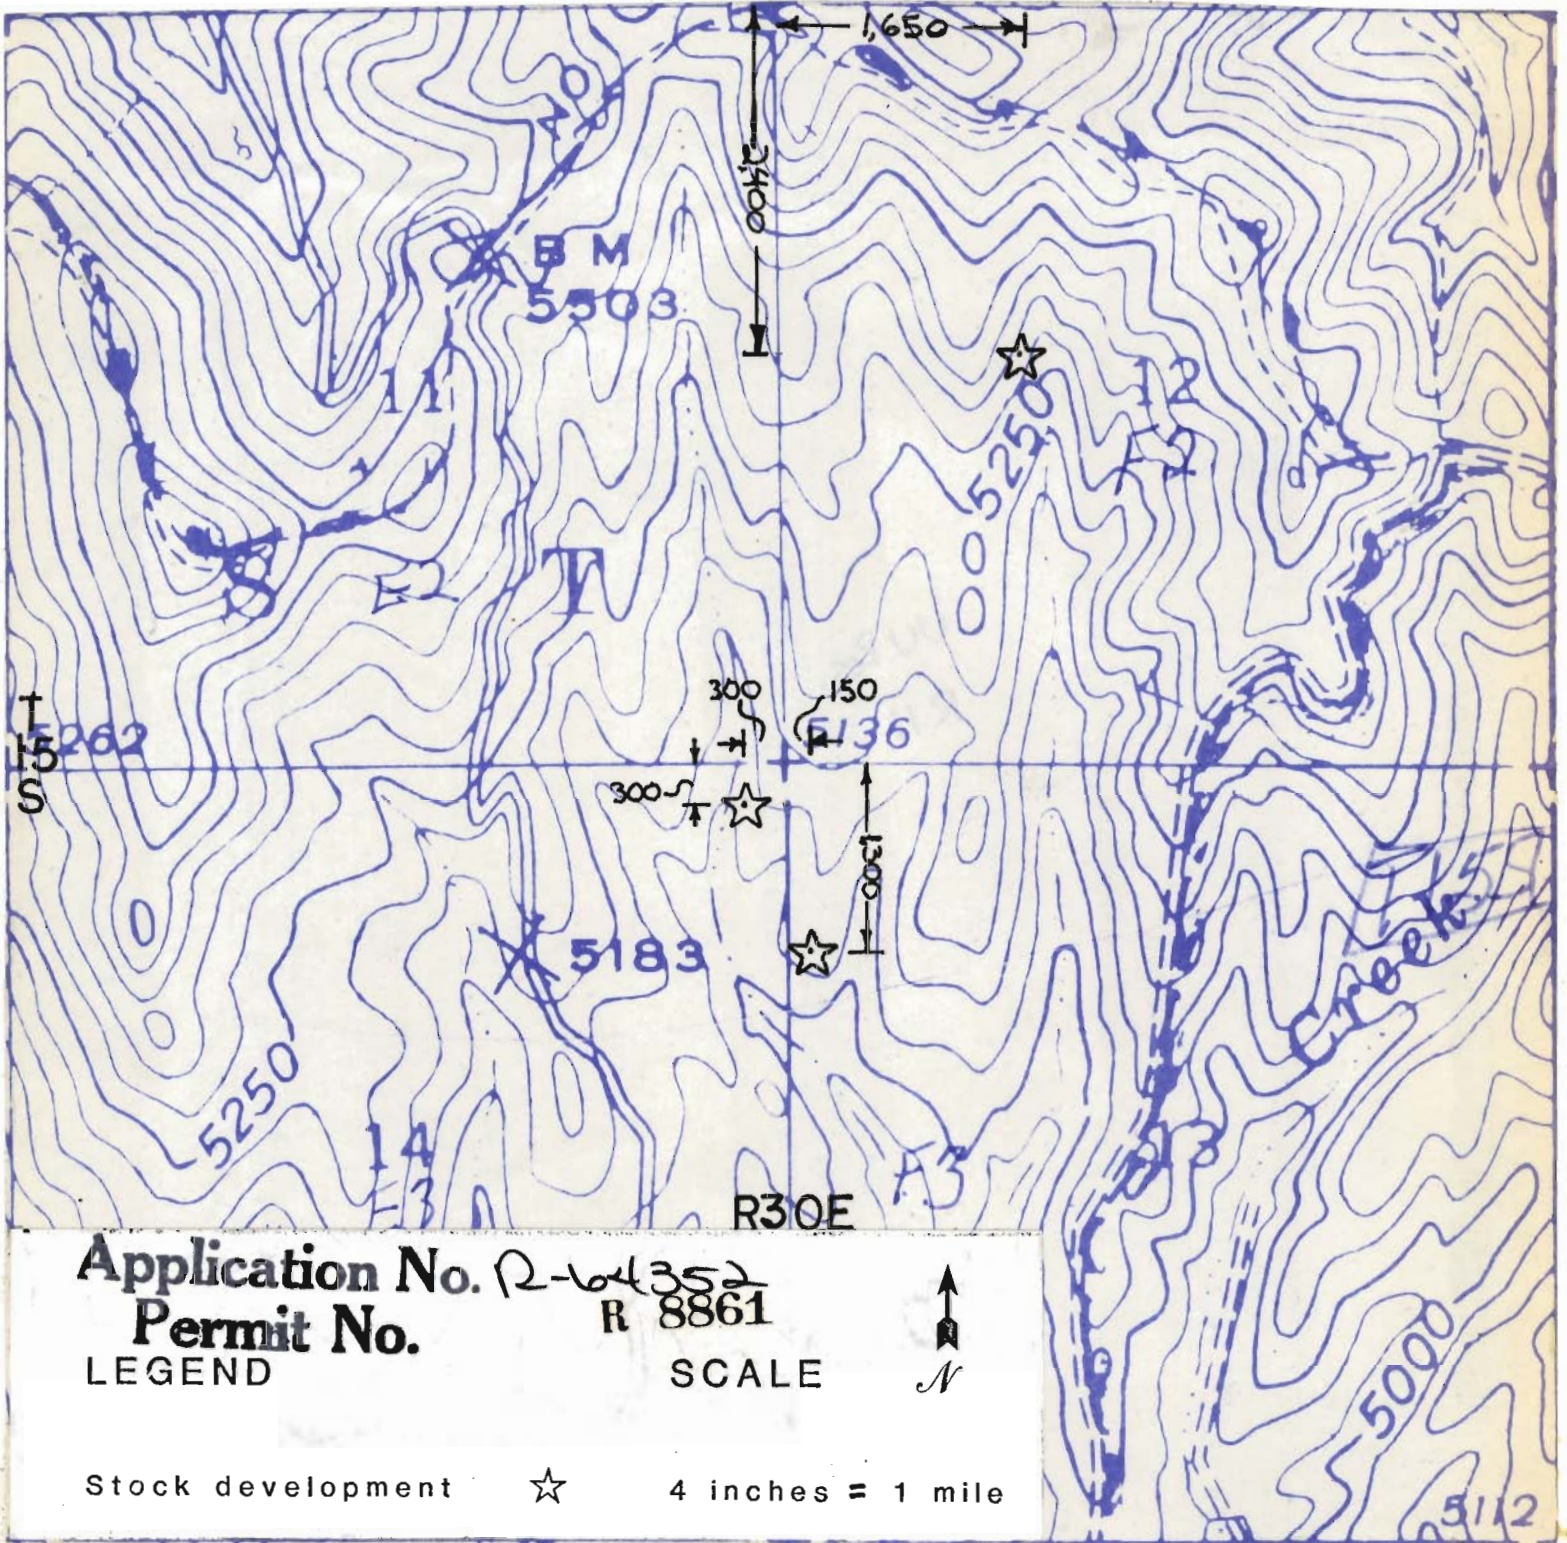

Application No. 12-64352
Permit No. R 8861

LEGEND

SCALE



Stock development



4 inches = 1 mile

RECEIVED

OCT 4 1982

WATER RESOURCES DEPT.
SALEM, OREGON