


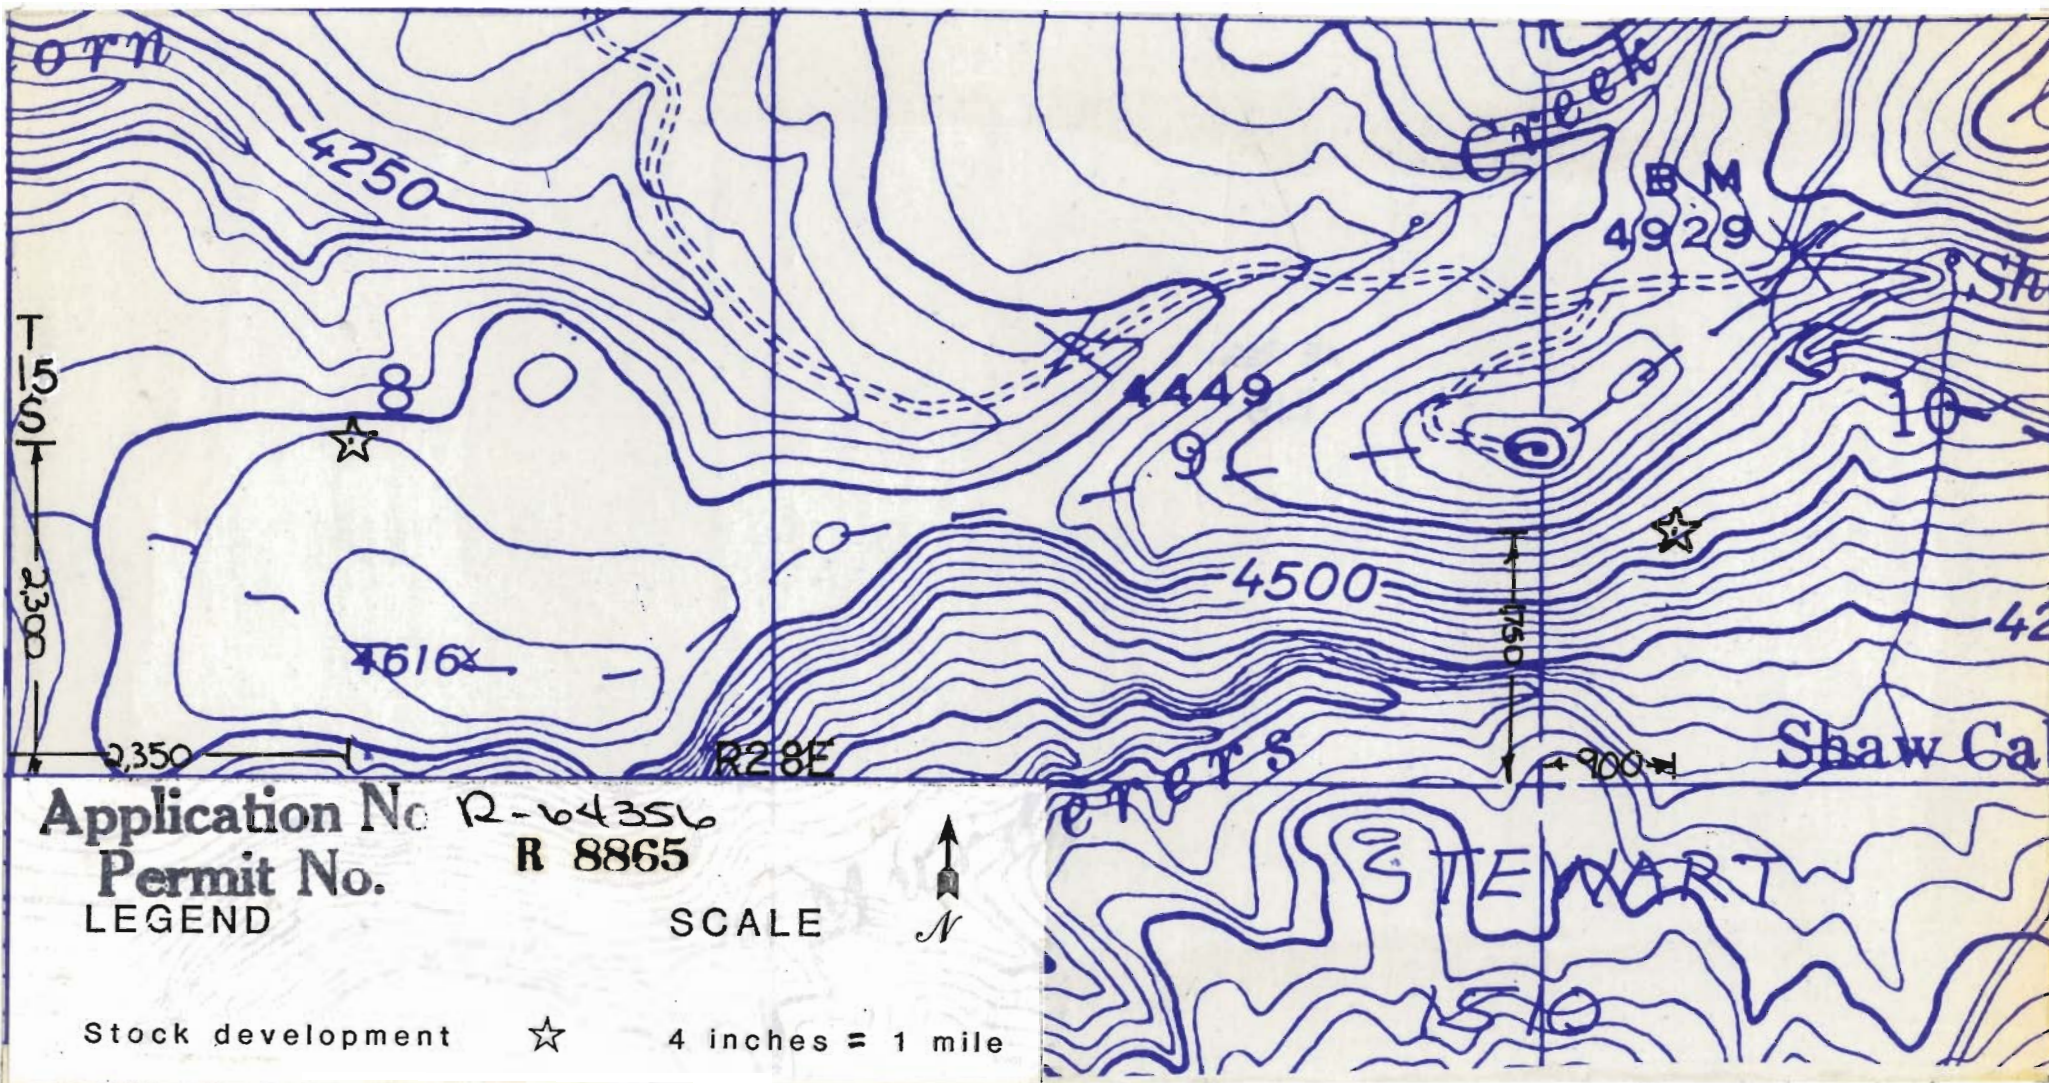

RECEIVED
OCT 4 1982
WATER RESOURCES DEPT.
SALEM, OREGON