


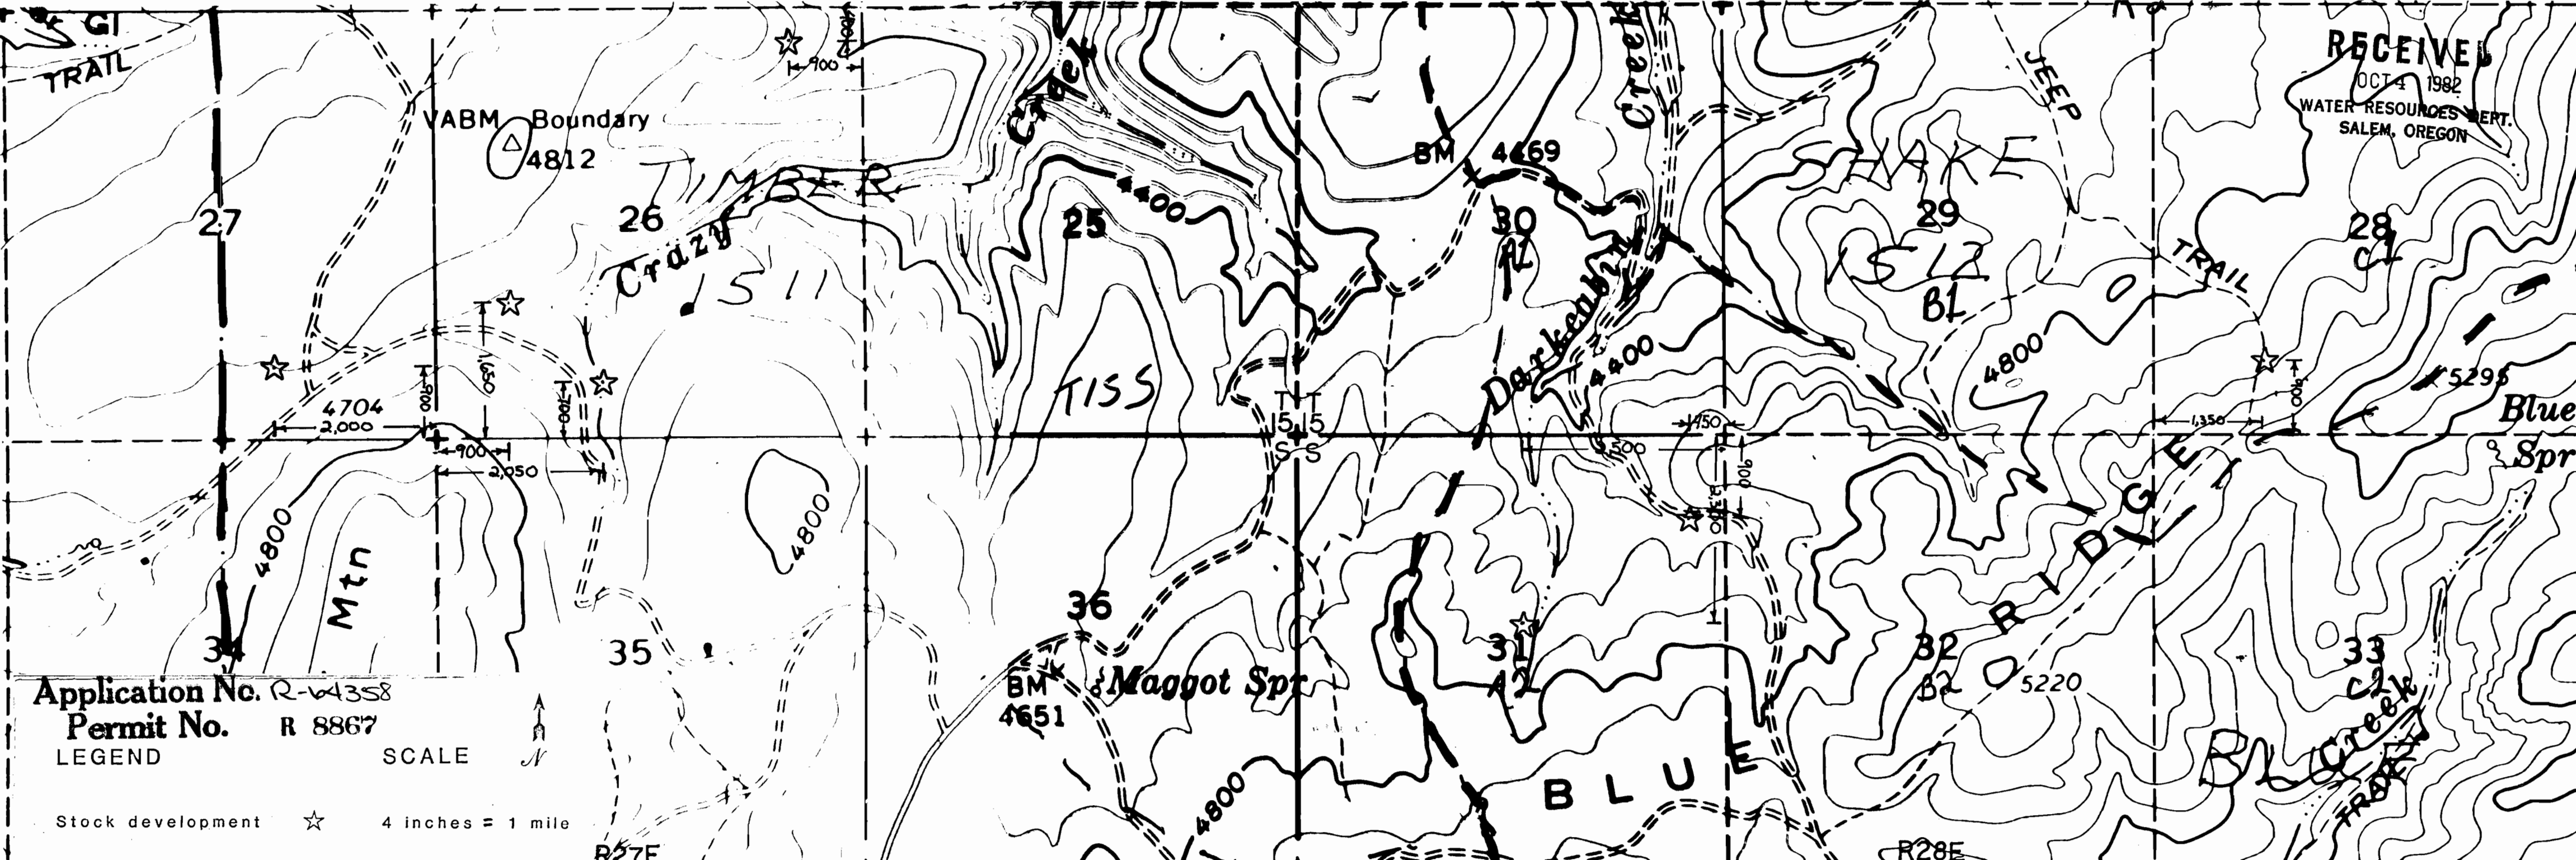

RECEIVED  
OCT 4 1982  
WATER RESOURCES DEPT.  
SALEM, OREGON

Application No. R-4358  
Permit No. R 8867

LEGEND  
Stock development ☆  
SCALE  
4 inches = 1 mile