


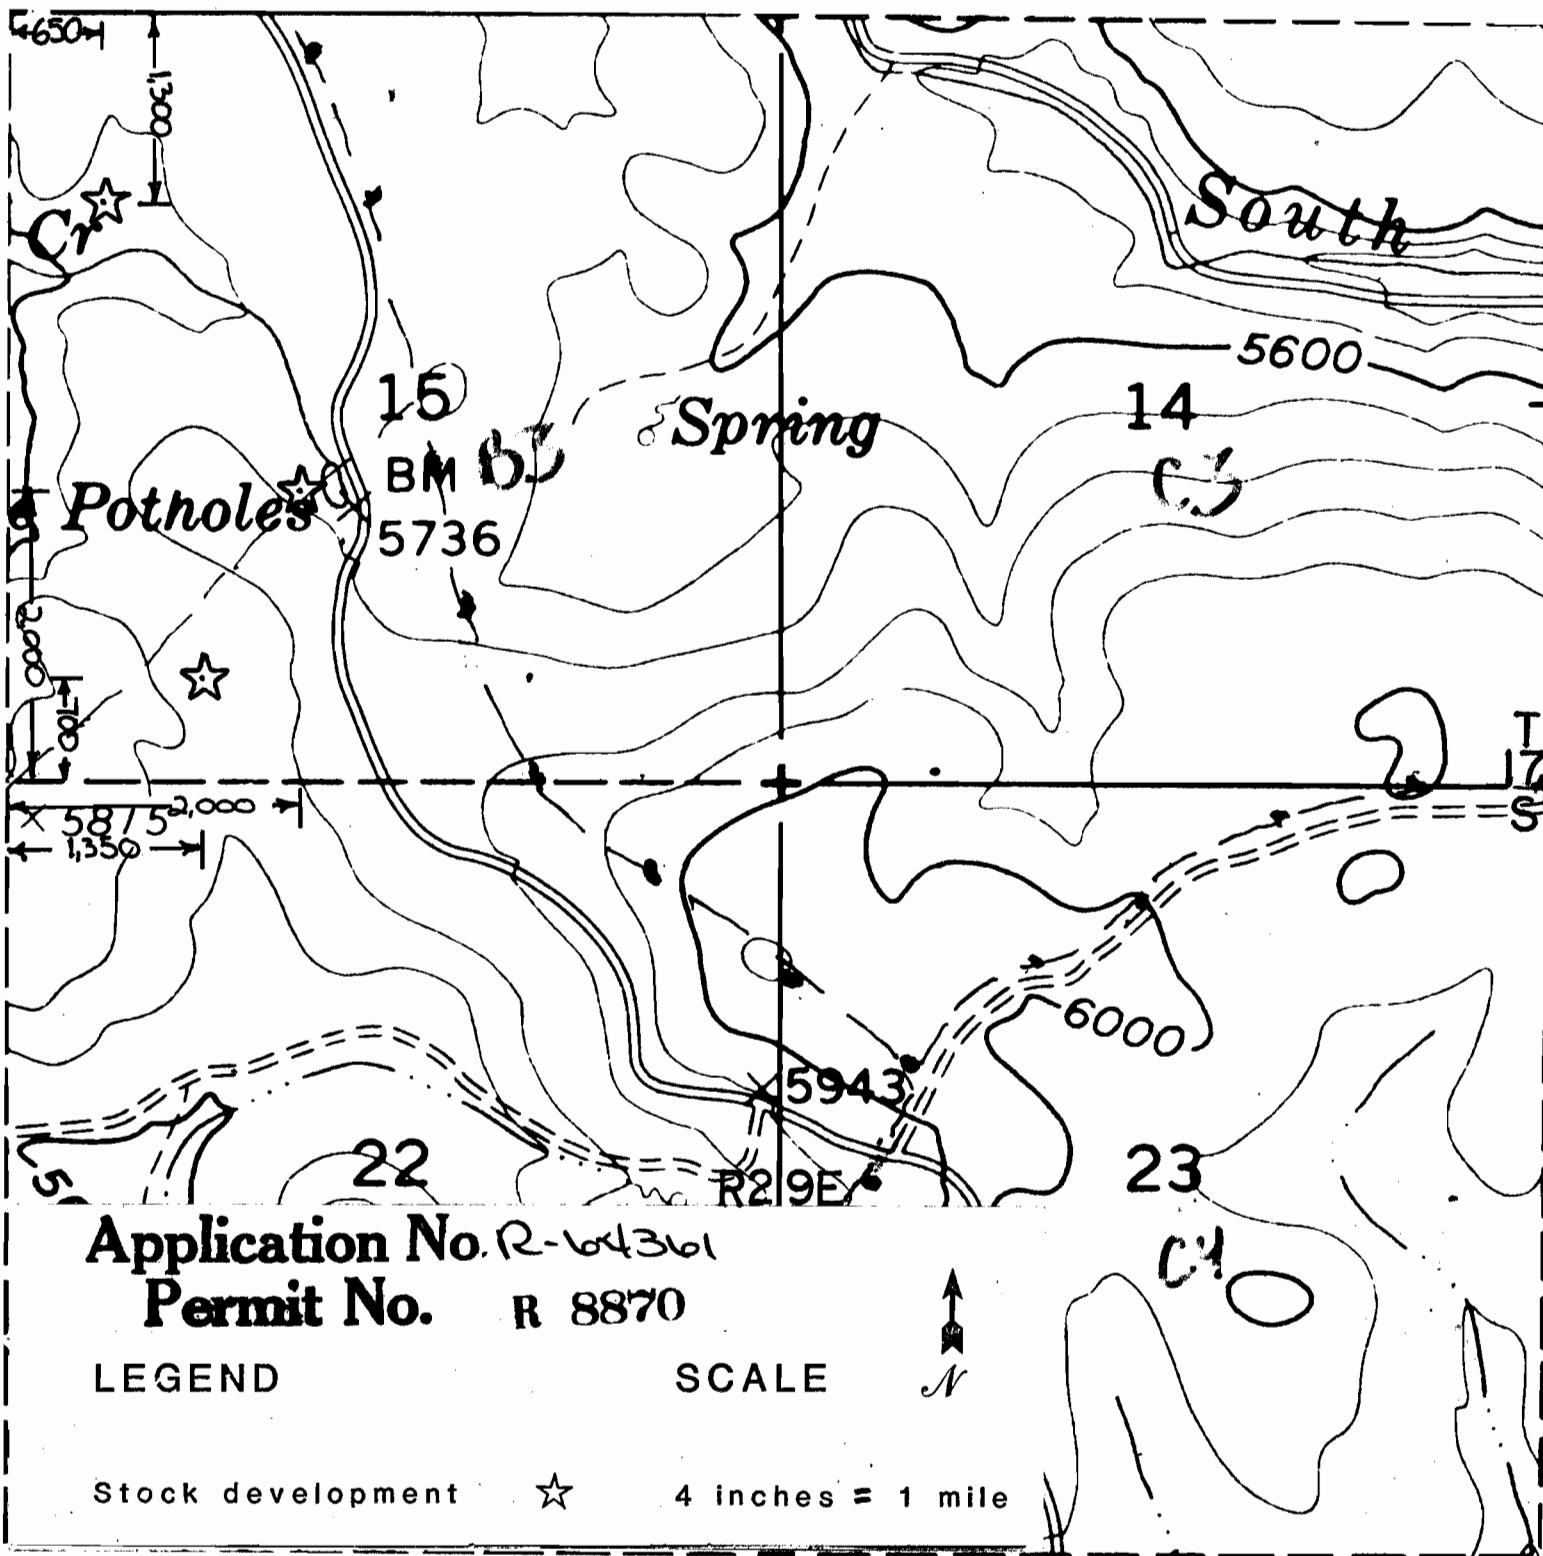

RECEIVED

OCT 4 1982

WATER RESOURCES DEPT.
SALEM, OREGON