


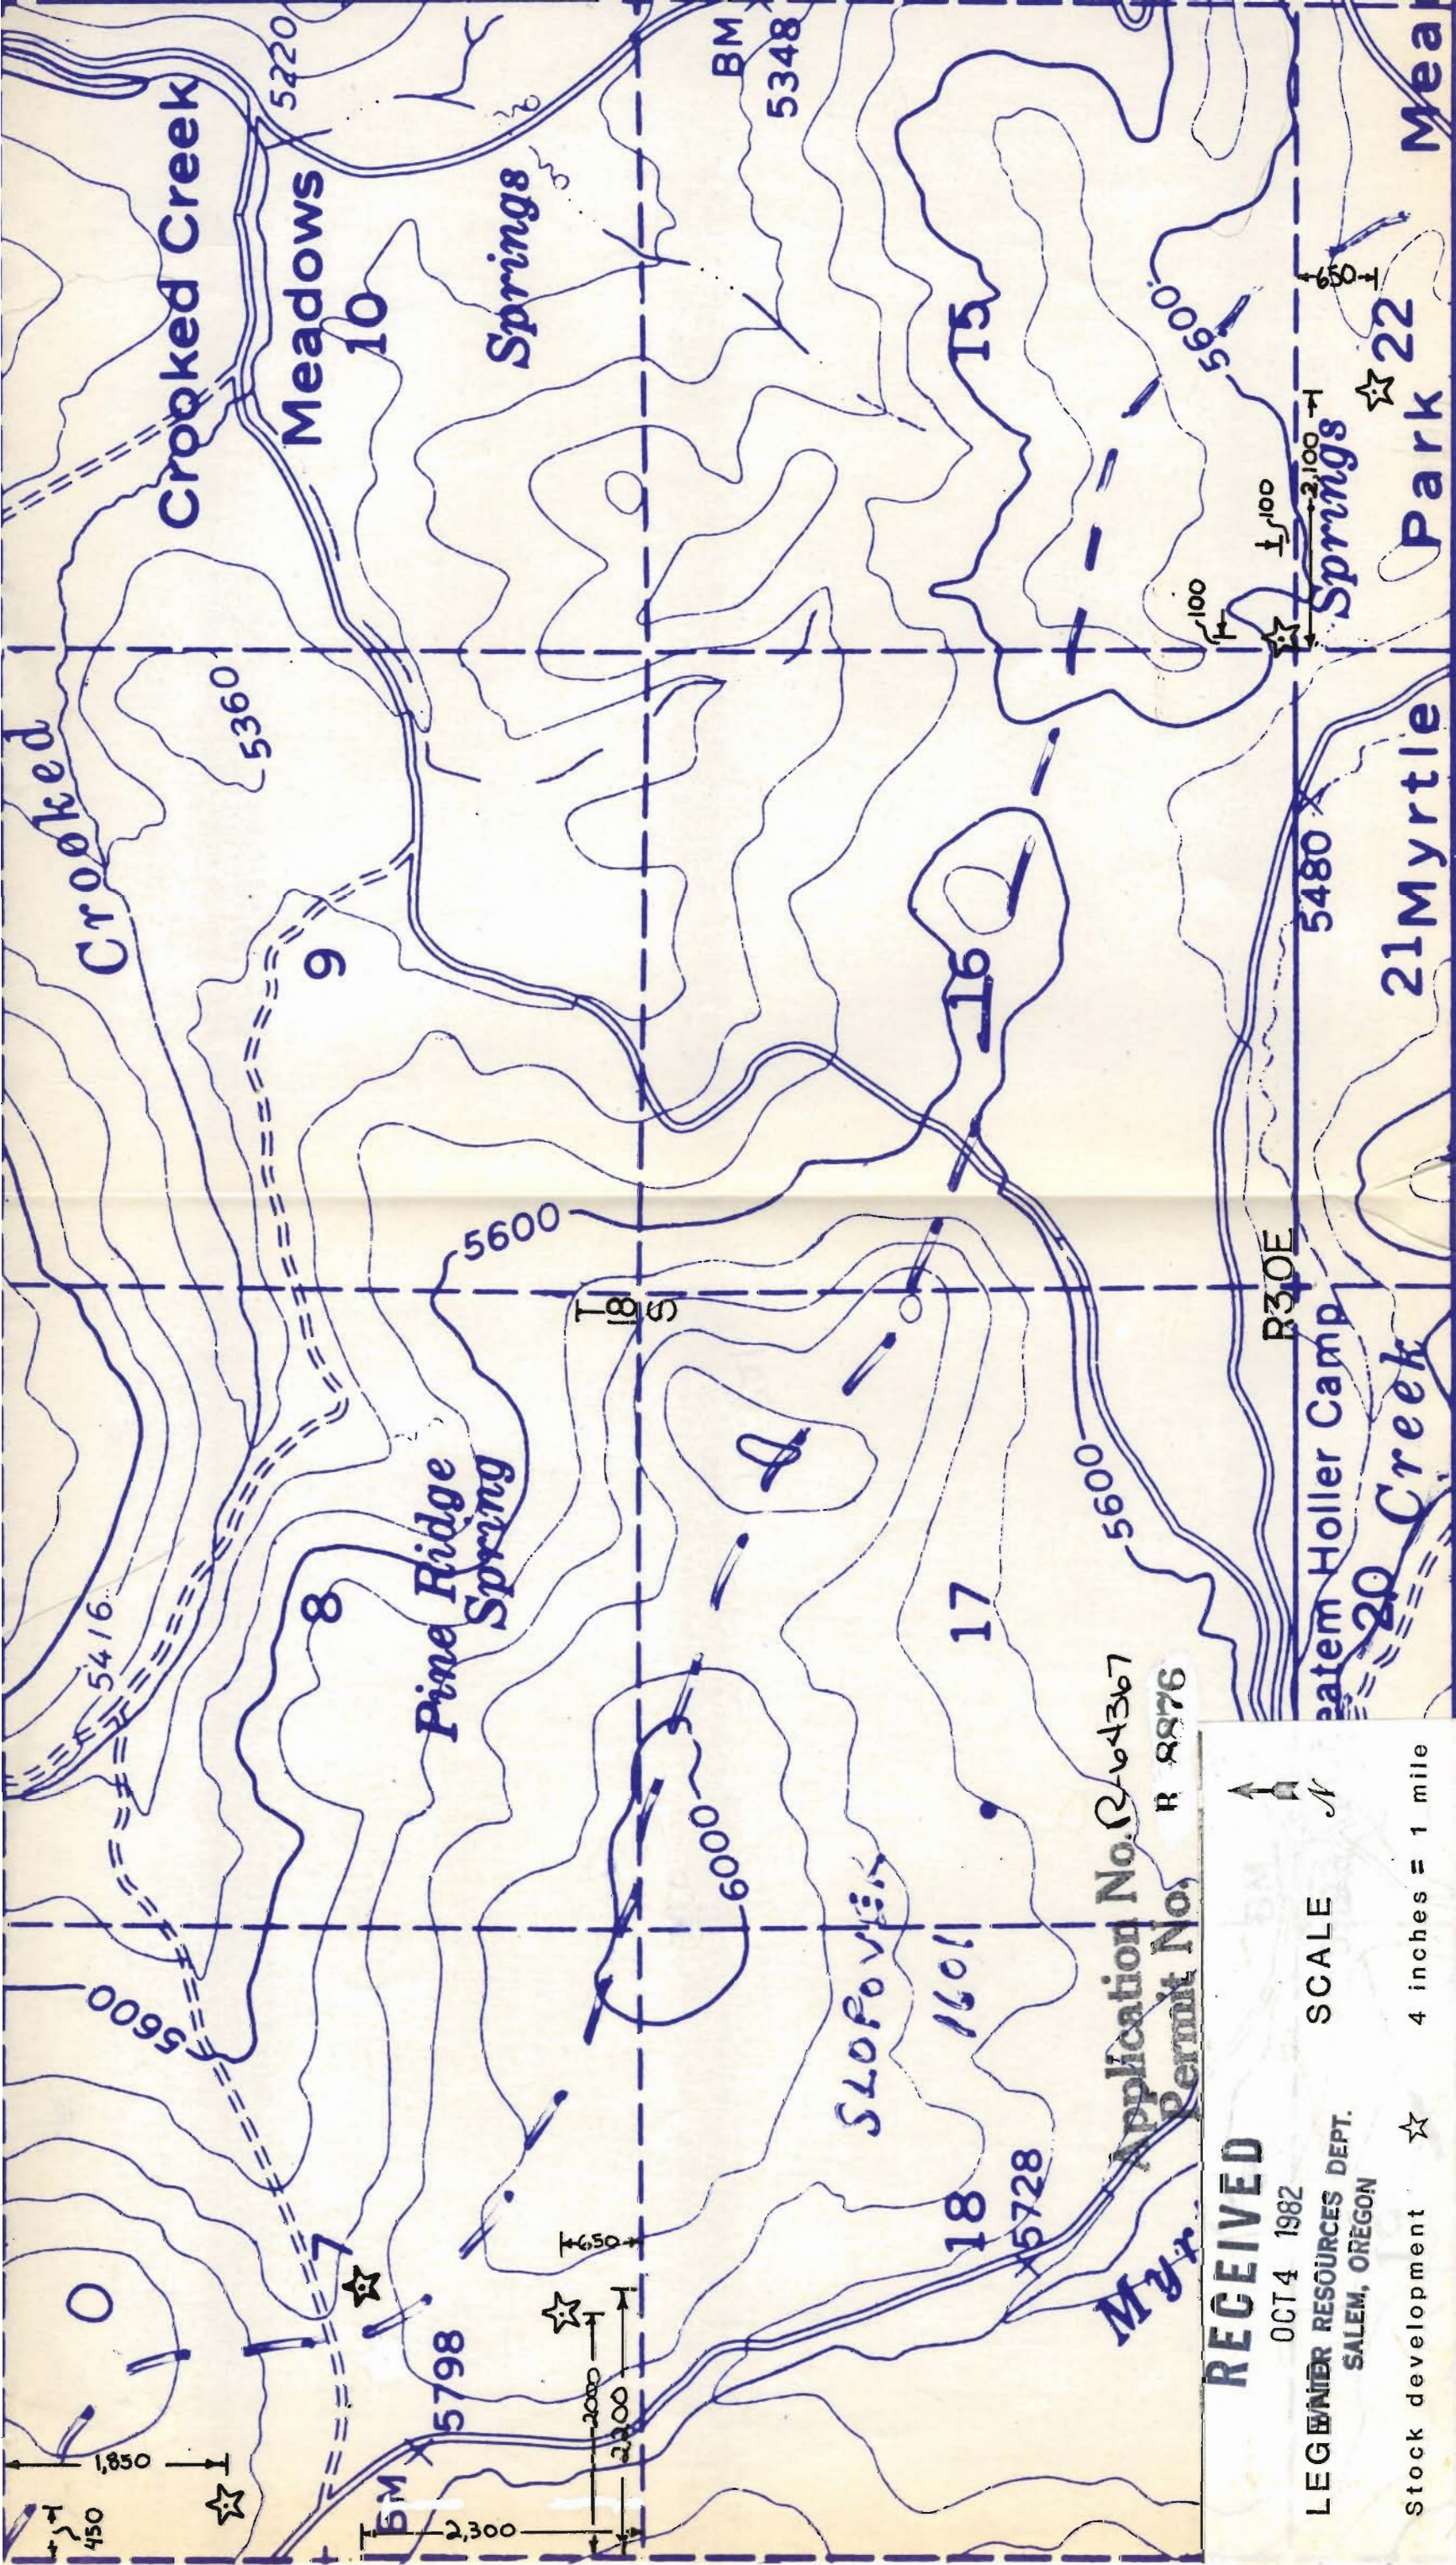

RECEIVED

OCT 4 1982

SALEM, OREGON

Stock development ☆ 4 inches = 1 mile

SCALE



Application No. R-64367
Permit No. R 8876

Myrtle Creek

Holler Camp

R30E

5480


☆ 22

Myrtle Park

Mear

18

1601

17

16

15

8

9

10

Pine Ridge Spring

5600

2300
2000
1850

18

6000

BM 5348

5220

Meadows

Crooked Creek

Crooked

☆

☆

☆

☆

☆

☆

☆