


Sec. 20-19

Tp. 9S

R. 33E

Per 8109
7748

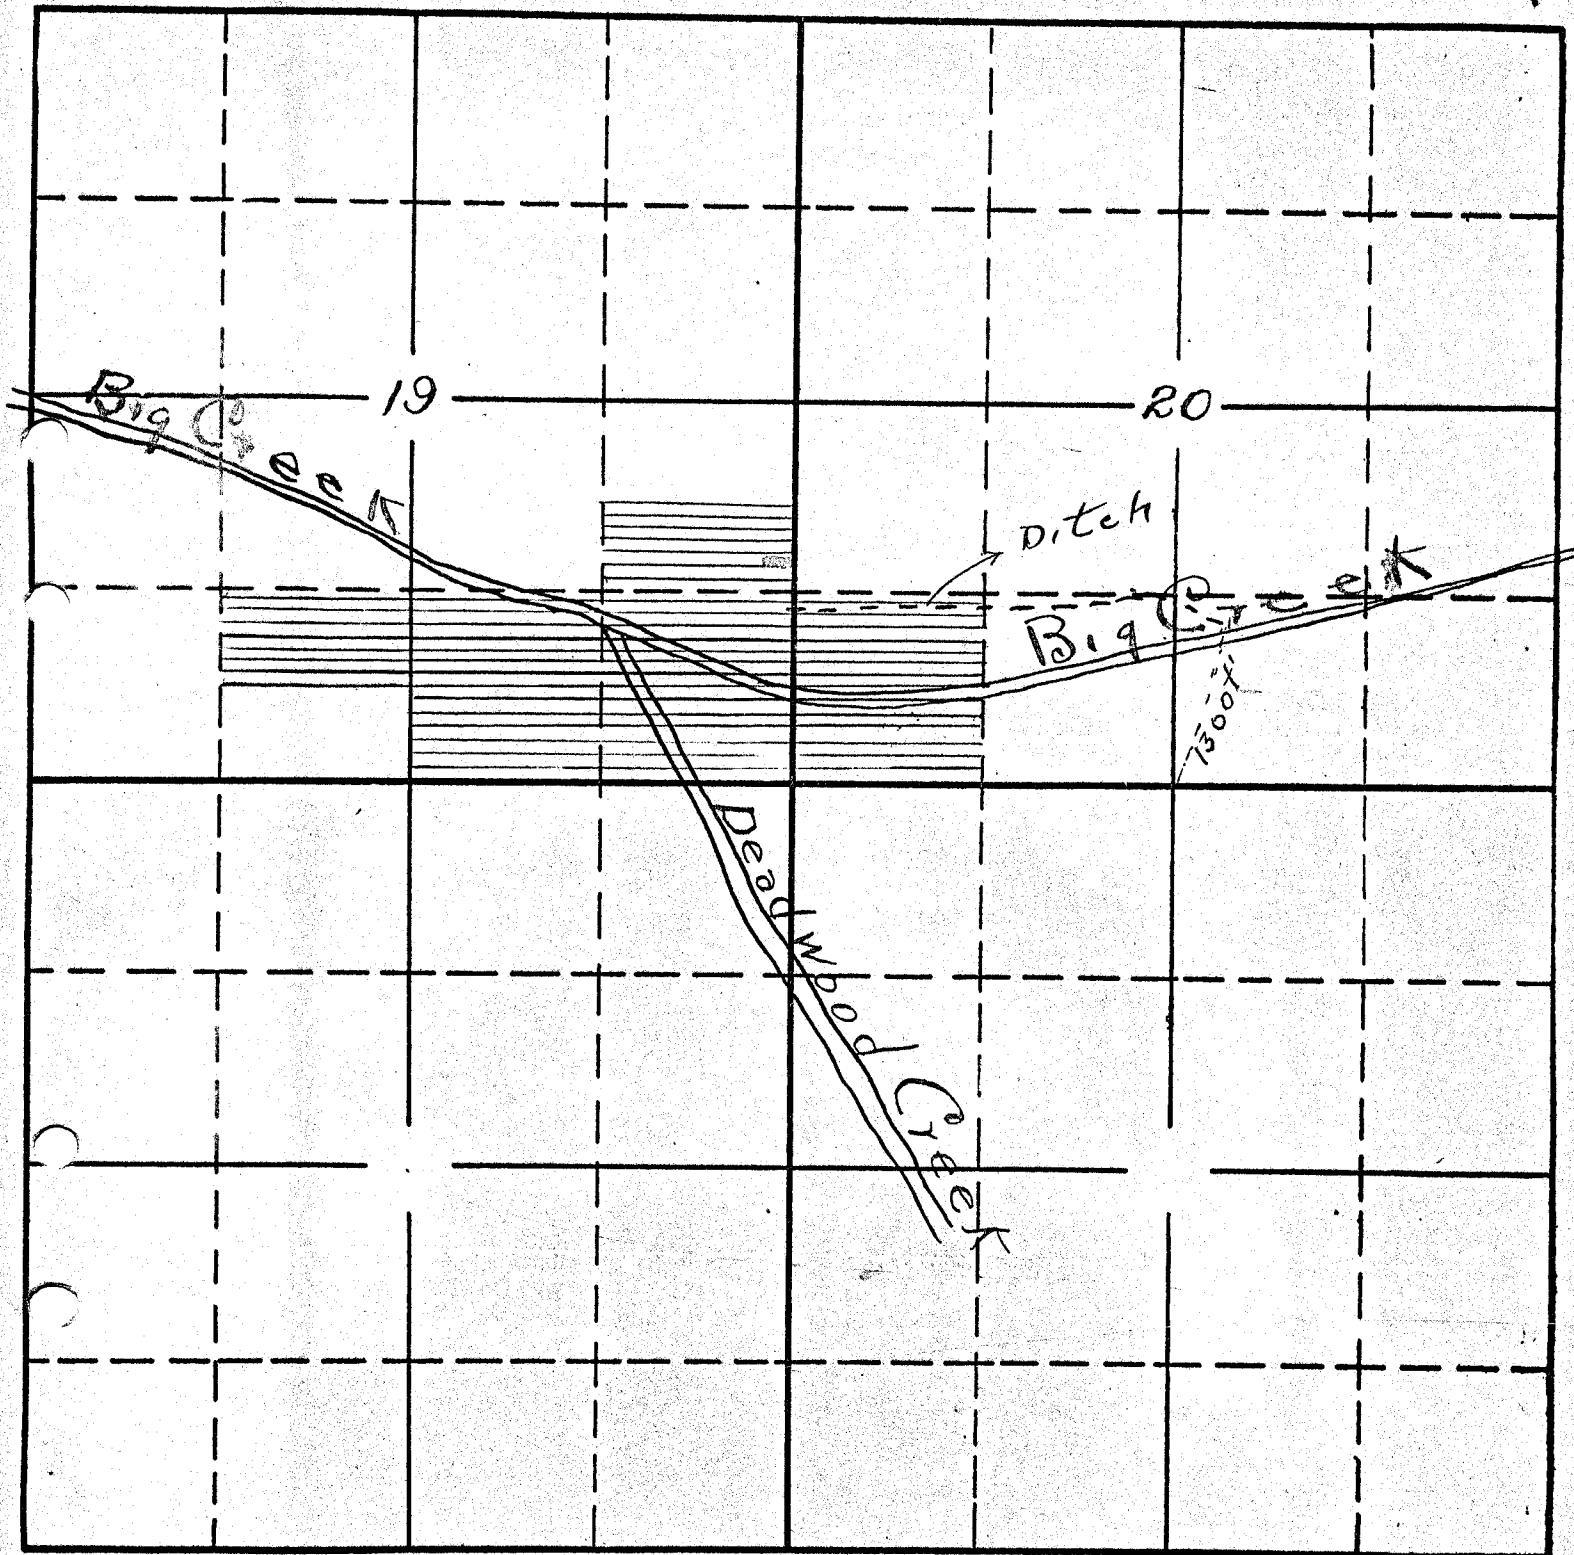

Application No.
Permit No.

11672
8109

11672