


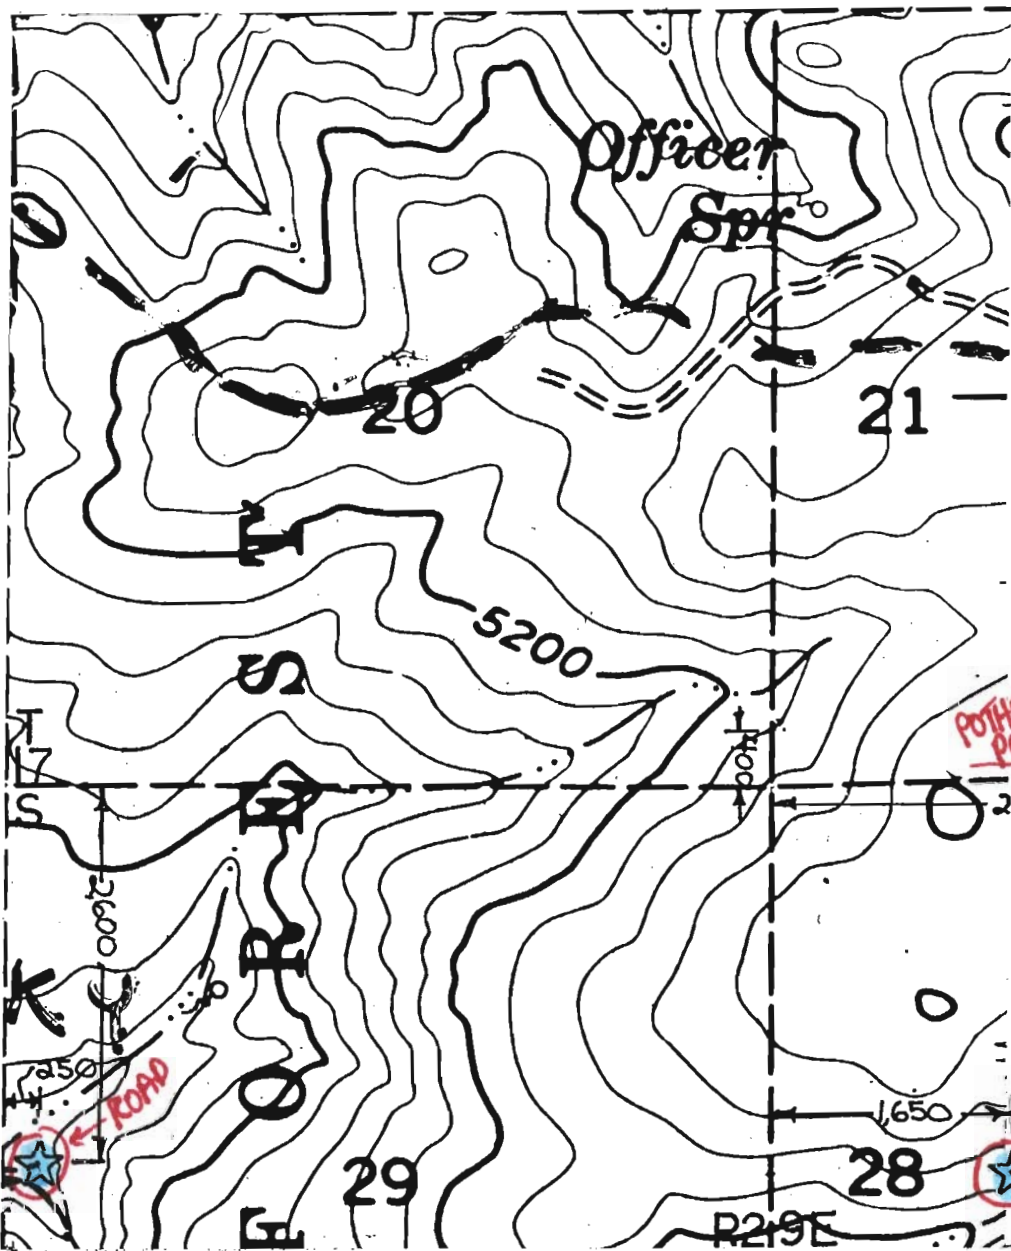

Application No R-64370

Permit No. R 8879

LEGEND

SCALE

Stock development



4 inches = 1 mile



RECEIVED

OCT 4 1982

WATER RESOURCES DEPT.
SALEM, OREGON